


**Map of
Claim of Beneficial Use
Balin Ranches
Application G-17177
Permit G-16554**

T 40 S, R 9 E, Sec. 11 WM

RECEIVED BY OWRD

MAY 19 2017

SALEM, OR

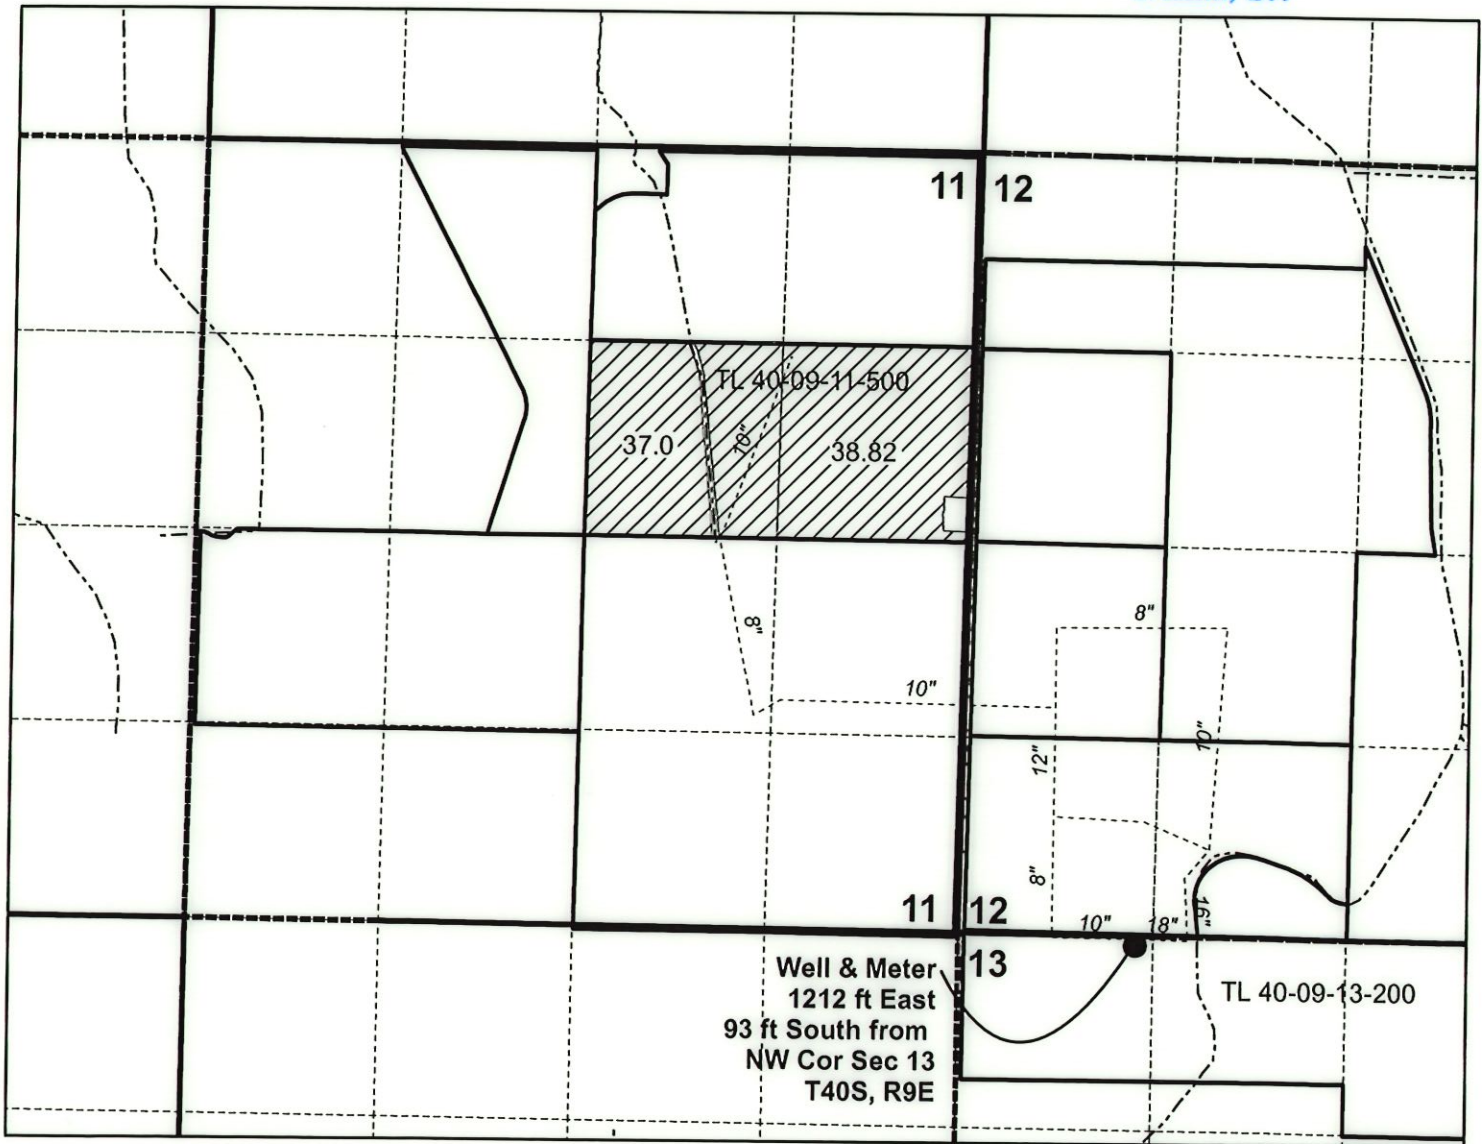

Legend

- Area irrigated
- Pipelines
- KID Canals



1 inch = 1,320 feet

Note: This map is not intended to provide legal dimensions or locations of property ownership lines.

