


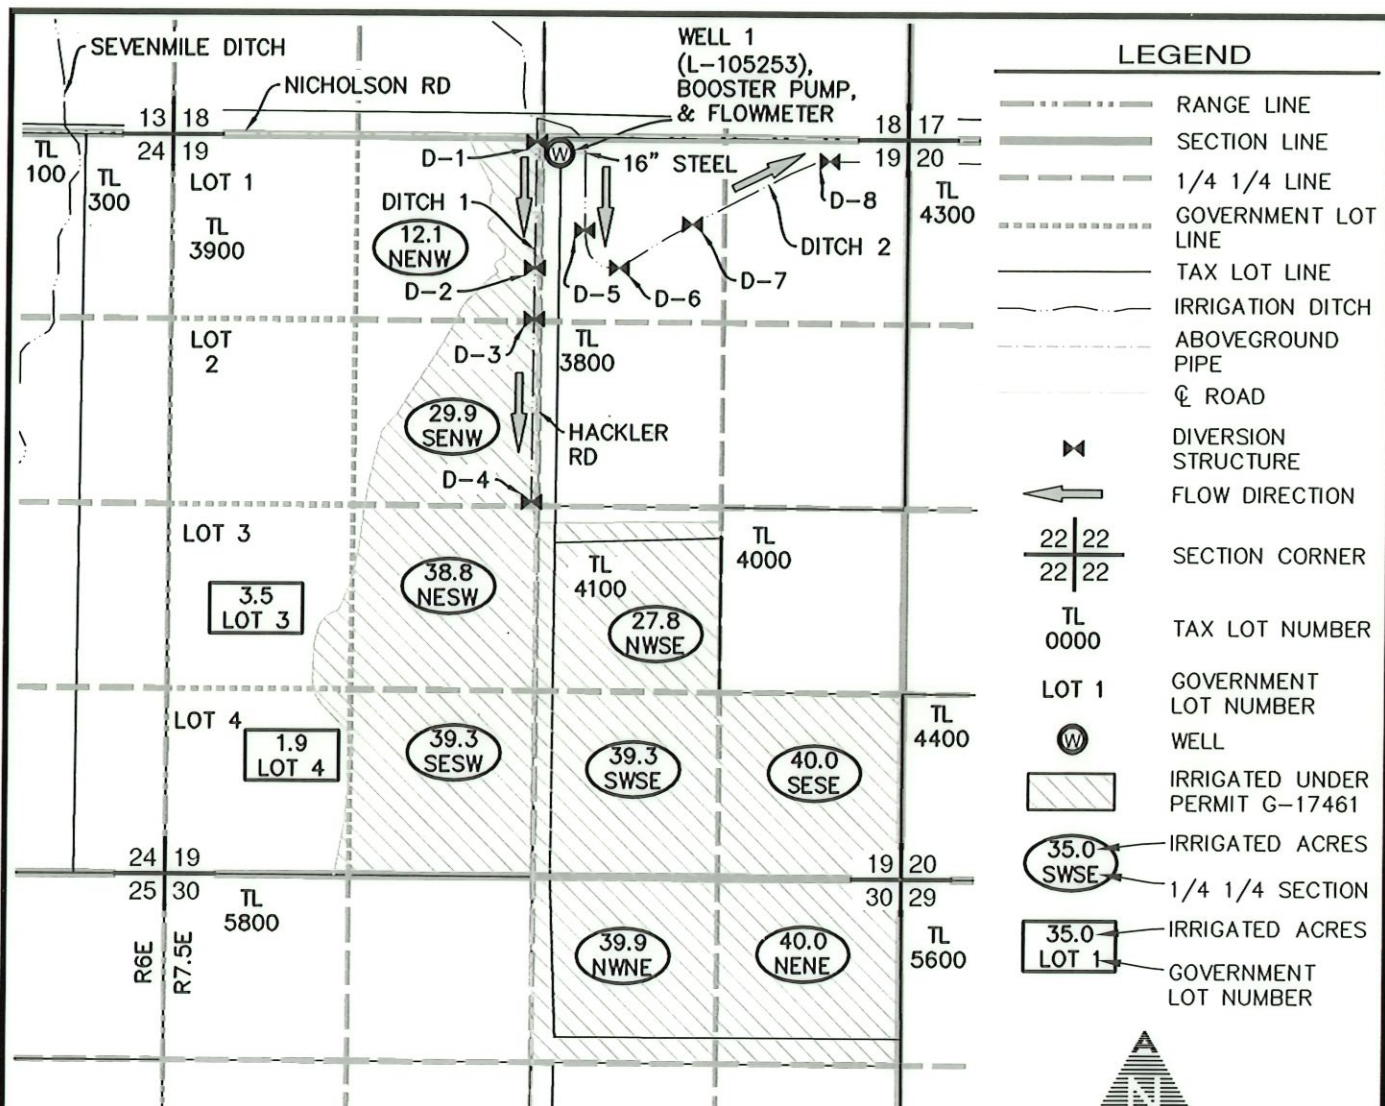

NOTES:


1. THIS MAP WAS PREPARED FROM FIELD MEASUREMENTS, NAIP 2020 AERIAL PHOTOGRAPH, KLAMATH COUNTY TAX MAPS, AND OREGON GLO MAPS.

2. THE PURPOSE OF THIS MAP IS TO IDENTIFY THE LOCATION OF THE WATER RIGHT ONLY, AND IS NOT INTENDED TO PROVIDE DIMENSIONS OR LOCATION OF PROPERTY LINES.

3. DATE OF PRIORITY FOR THIS WATER RIGHT IS OCTOBER 15, 2014.

WELL LOCATION:

WELL 1 (L-105253): 105' SOUTH & 169' EAST FROM THE NORTH QUARTER CORNER OF SECTION 19.

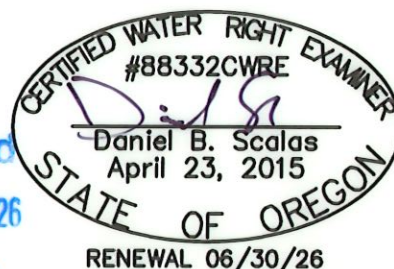

AL ADKINS
ENGINEERING & SURVEYING
o / 541.884.4666
w / AdkinsEngineering.com

1435 ESPLANADE AVENUE, KLAMATH FALLS, OR 97601

SERVING S. OREGON & N. CALIFORNIA

ENGINEERING • SURVEYING • PLANNING • TESTING

1266-11

CLAIM OF BENEFICIAL USE AND FINAL PROOF MAP

FOR

PRODUCTIVE TIMBERLAND LLC AND NBCC LLC
T33S, R6E, SEC. 24, W.M.
T33S, R7.5E, SECS. 19 & 30, W.M.
KLAMATH COUNTY, OREGON
PERMIT G-17461
APPLICATION G-17942