


EXPIRES: 2/21/2031

T. 3S. R3W., W.M.

Red Hills Estates

SECTION 26
YAMHILL COUNTY
PO Box 534
DUNDEE, OREGON 97115

PREPARATION OF THIS MAP IS FOR THE PURPOSE OF IDENTIFYING THE LOCATION OF THE WATER RIGHT ONLY. THERE IS NO INTENT TO PROVIDE DIMENSIONS OR LOCATION OF PROPERTY OWNERSHIP LINES.

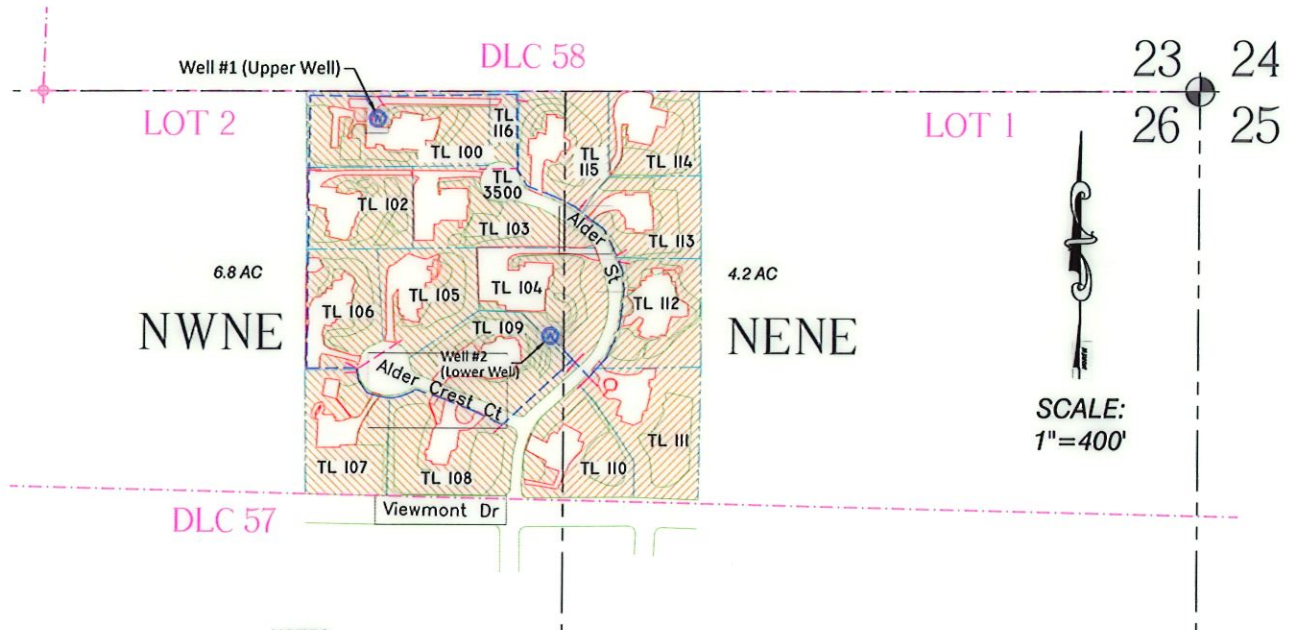

NOTES:

WELL #1 (Upper Well) IS LOCATED 60 FT SOUTH AND 1720 FT WEST;
WELL #2 (Lower Well) IS LOCATED 500 FT SOUTH AND 1350 FT WEST, FROM THE NE CORNER OF SECTION 26.

FLOW METER LOCATIONS: A FLOW METER IS LOCATED WITHIN 1.5 FT OF EACH WELL HEAD.

RECEIVED

MAY 06 2020

OWRD

LEGEND

---	USGS GRID
---	ROADWAY
---	PROPERTY LINE
---	DLC BOUNDARY
---	4" MAINLINE
---	STUB WATER LINE & METER
---	STRUCTURE
+	SECTION CORNER
+	DLC CORNER
+	WELL (P.O.D.)
+	PLACE OF USE (P.O.U.)

Survey
AND CLAIM OF BENEFICIAL USE
IN THE NAME OF
RED HILLS ESTATES HOMEOWNERS ASSOCIATION

FILE PATH & NAME: C:\Users\20-115-10\Google Drive\PERSONAL\RED HILLS ESTATES\R3\RED HILLS ESTATES 042220.dwg

BK WATER RIGHT CONSULTING
PO Box 13434 Salem, Oregon 97309

Red Hills Estates

APPLICATION#: G-14822 PERMIT#: G-13671 AMENDMENT#: x-xxxxx SHEET 1 OF 1