



T. 40S., R 09E., Sec. 2, W.M.
Klamath County, Oregon
Application: G-15485 Permit: G-15130

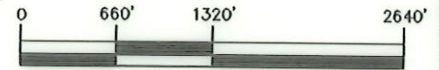

SCALE: 1" = 1320'



TAX LOT NUMBER 4009-00020-01200

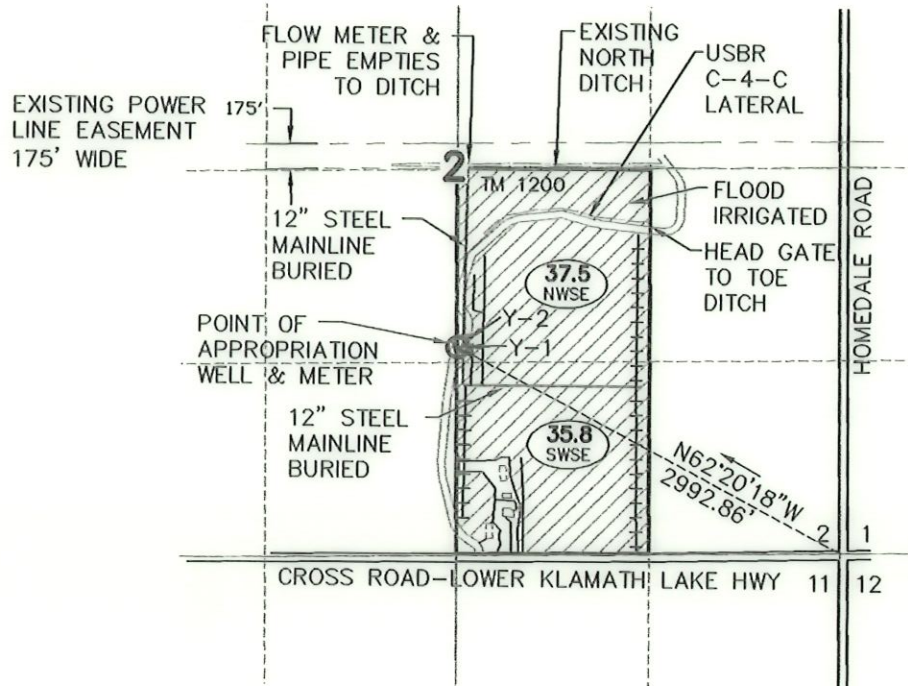

NOTES:

1. THIS MAP WAS PREPARED FROM FIELD MEASUREMENTS, NAIP 2005 AERIAL PHOTOGRAPH, KLAMATH COUNTY TAX MAP 400902, AND OREGON GLO MAPS.
2. THE PURPOSE OF THIS MAP IS TO IDENTIFY THE LOCATION OF THE WATER RIGHT ONLY, AND IS NOT INTENDED TO PROVIDE DIMENSIONS OR LOCATION OF PROPERTY LINES.

TOTAL ACRES IRRIGATED THIS CLAIM: 73.3

GOV'T LOT	1/4 1/4	SECTION	TOWNSHIP	RANGE	# IRRIGATED ACRES
0	NW SE	2	40S	9E	37.5
0	SW SE	2	40S	9E	35.8

TOTAL ACRES IRRIGATED: 73.3

RECEIVED

JUN 08 2009


**WATER RESOURCES DEPT
SALEM, OREGON**

LEGEND

- TOTAL ACRES IRRIGATED PER 1/4 1/4
- IRRIGATED LANDS THIS CLAIM OF BENEFICIAL USE
- 1/4 1/4 SECTION
- EXISTING STRUCTURE
- 2** SECTION DESIGNATION
- 1/4 1/4 SECTION LINES
- ROADS

- PROPERTY BOUNDARY
- EXISTING USBR LATERAL
- WHEEL LINES
- HAND LINES
- MAIN LINES
- TAX MAP NUMBER

John E Bonner
Applicant signature

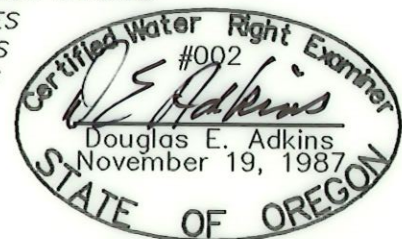

RENEWAL 12/31/09

ADKINS

CONSULTING
ENGINEERS, INC.

Engineers ▲ Planners ▲ Surveyors

2950 Shasta Way · Klamath Falls, Oregon 97603 · (541) 884-4666 · FAX (541) 884-5335
 Klamath Falls, OR · Medford, OR · Alturas, CA

Jan. 20, 2009

FP-Base

2903-01

FINAL PROOF MAP

for

John Bonner

Klamath County, Oregon