


AMENDED

CLAIM OF BENEFICIAL USE MAP


TO ACCOMPANY COBU REPORTS FOR
GROUND WATER PERMITS G-15320 & G-15770
RICHARD WALSH & KLAMATH HILLS WATER CO.

E-RECEIVED
AUGUST 6 2026
OWRD

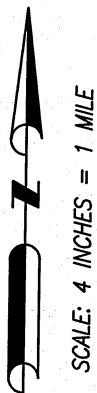


SCALE: 4 INCHES = 1 MILE

TOWNSHIP 40 SOUTH RANGE 9 EAST, SECTION 24, W.M.
ALL IN KLAMATH COUNTY, OREGON
TAX LOT 2900

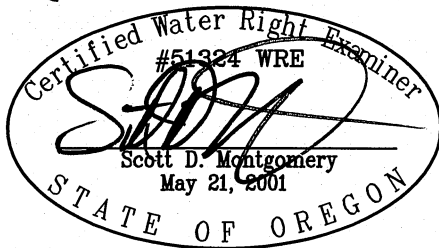


RENEWAL DATE: 12/31/2026


THIS MAP IS FOR THE PURPOSE OF
LOCATING A WATER RIGHT ONLY AND HAS
NO INTENT TO PROVIDE LEGAL DIMENSIONS
OR THE LOCATION OF PROPERTY LINES

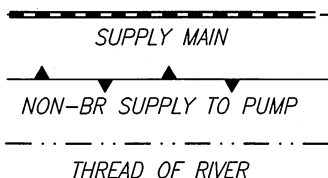

BR = BUREAU OF RECLAMATION
RR = RAILROAD

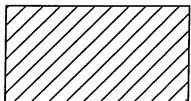

46.6 SUPPLEMENTAL
IRRIGATION ACRES FROM
G-15770, AS SHOWN.

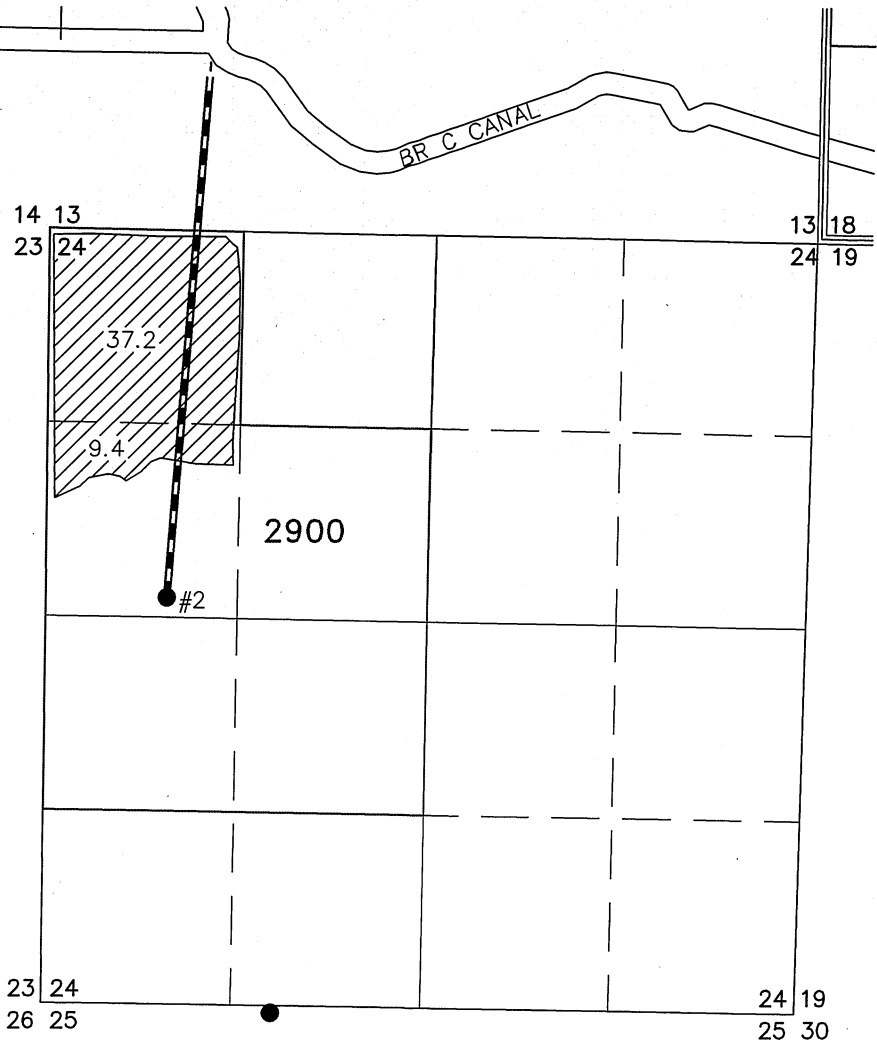

WELL 2 (KLAM 52923)

LOCATED IN THE SW 1/4 NW 1/4 SECTION
24 AND 2515 SOUTH AND 835 FEET EAST
FROM THE NW CORNER THEREOF.

PREPARED FOR:

KLAMATH HILLS WATER Co.
5541 SYLVIA AVE.
KLAMATH FALLS, OR 97603

PREPARED BY:



ALL POINTS ENGINEERING AND SURVEYING, INC.
P.O. BOX 767 (CRR) TERREBONNE, OR 97760
(541) 548-5833
www.APEandS.com