



T. 3S. R3W., W.M.

Red Hills Estates

SECTION 26  
YAMHILL COUNTY  
PO Box 534  
DUNDEE, OREGON 97115


PREPARATION OF THIS MAP IS FOR THE PURPOSE OF IDENTIFYING THE LOCATION OF THE WATER RIGHT ONLY. THERE IS NO INTENT TO PROVIDE DIMENSIONS OR LOCATION OF PROPERTY OWNERSHIP LINES.

EXPIRES: 2021.12.31

RECEIVED

MAY 06 2020

OWRD

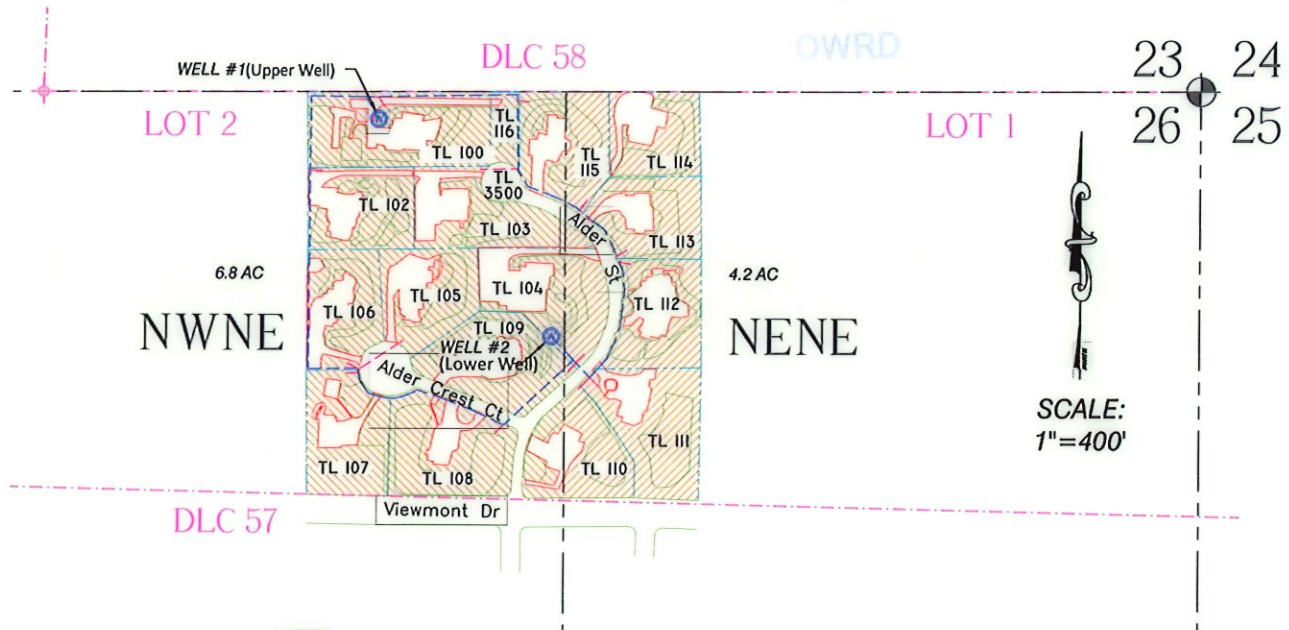

NOTES:

WELL #1 (Upper Well) IS LOCATED  
60 FT SOUTH AND 1720 FT WEST;  
WELL #2 (Lower Well) IS LOCATED  
500 FT SOUTH AND 1350 FT WEST,  
FROM THE NE CORNER OF  
SECTION 26.

FLOW METER LOCATIONS: A FLOW METER IS  
LOCATED WITHIN 1.5 FT OF EACH WELL  
HEAD.

LEGEND

|     |                         |
|-----|-------------------------|
| --- | USGS GRID               |
| --- | ROADWAY                 |
| --- | PROPERTY LINE           |
| --- | DLC BOUNDARY            |
| --- | 4" MAINLINE             |
| --- | STUB WATER LINE & METER |
| --- | STRUCTURE               |
| --- | SECTION CORNER          |
| --- | DLC CORNER              |
| --- | WELL (P.O.D.)           |
| --- | PLACE OF USE (P.O.U.)   |

**Survey**  
**AND CLAIM OF BENEFICIAL USE**  
**IN THE NAME OF**  
**RED HILLS ESTATES HOMEOWNERS ASSOCIATION**

FILE PATH & NAME: C:\Users\20-115-10\Google Drive\PERSONAL\RED HILLS ESTATES\R3\RED HILLS ESTATES 042220.dwg

BK WATER RIGHT CONSULTING  
PO Box 13434 Salem, Oregon 97309

**Red Hills Estates**

APPLICATION#: G-16451 PERMIT#: G-16060 AMENDMENT#: x-xxxxx SHEET 1 OF 1