

T3S R2W WM

YAMHILL COUNTY

--- Tax Lot Line



Residence




Utility Building



Irrigation

NOTE: 3-INCH
TRANSMISSION PIPE
RUNS WEST, OUT
OF WELL SITE, THEN
FOLLOWS EDGE OF
RIGHT-OF-WAY
SOUTH AND EAST.

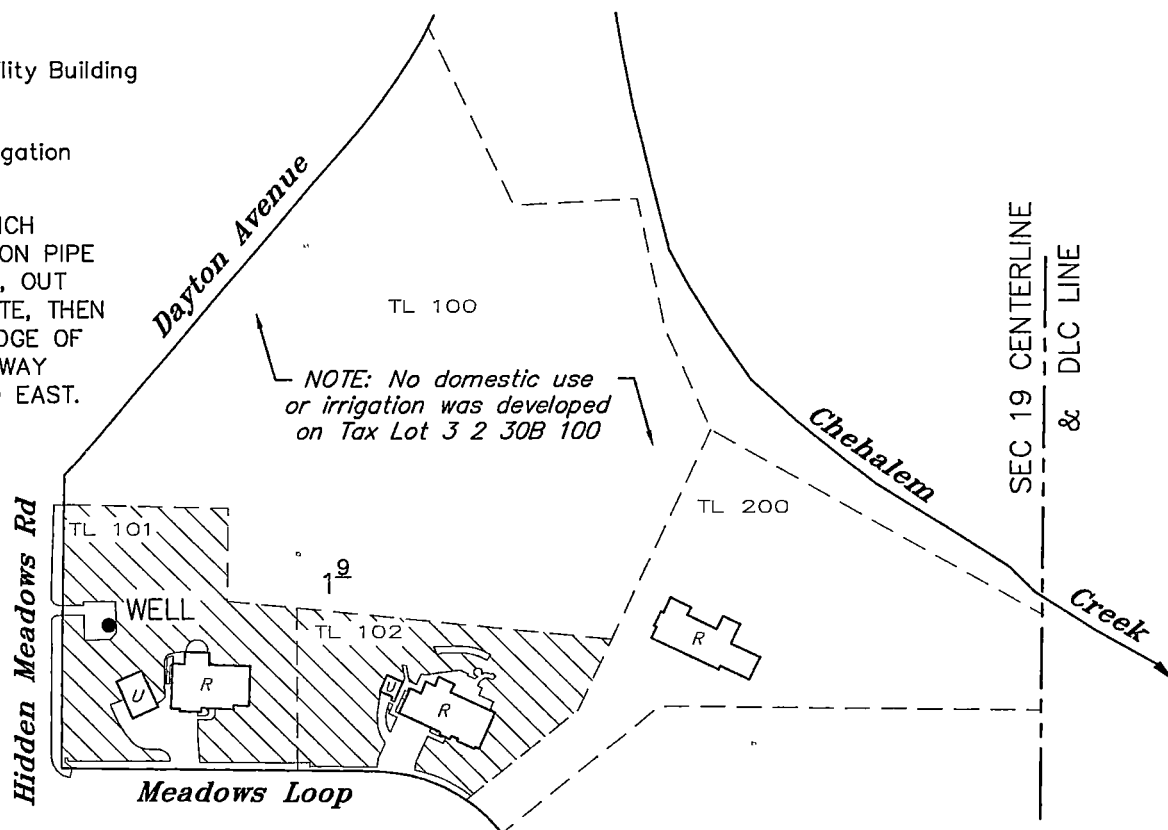

WELL: 1997' NORTH and 940' WEST of BRASS DISC at SW COR RODGERS DLC No. 55
(148' NORTH & 41' EAST of SW COR LOT 1, HIDDEN MEADOWS SUBDIVISION)

METER: 2' WEST OF WELL, READOUT IS WALL MOUNTED 12' SOUTH and 7' WEST OF THE WELL

CLAIM OF BENEFICIAL USE

UNDER

APPLICATION G-17517 PERMIT G-16985


IN THE NAME OF

HIDDEN MEADOWS WATER ASSOCIATION

SEPTEMBER 13, 2022

SCALE 1" = 200'

NOTE: This map is for the purpose of
identifying the location of water rights
and has not intent to dimension or locate
property ownership lines.

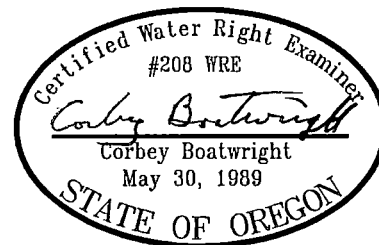

RENEWES: 12-31-25