
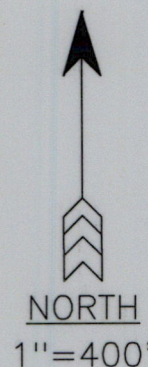


CLAIM OF BENEFICIAL USE MAP
APPLICATION G-17949, PERMIT G-17449
SECTION 4, TOWNSHIP 39 SOUTH, RANGE 3 WEST W.M.
JACKSON COUNTY, OREGON

RECEIVED

OCT 11 2022

OWRD

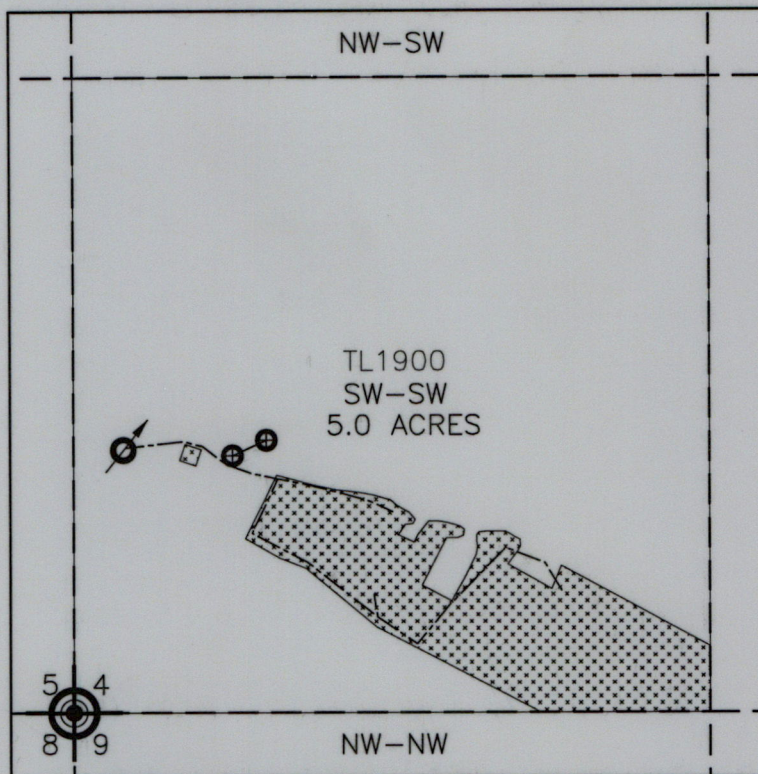

LEGEND

(SYMBOLS NOT TO SCALE)




POINT OF BEGINNING (P.O.B.):
SW COR. SEC. 4, T.39S., R.3W.,
W.M.




POINT OF APPROPRIATION(P.O.A.):
P.O.A. #1: 547 FT. NORTH &
103 FT. EAST FROM P.O.B.




STORAGE TANK
#1 535 FT. NORTH & 330 FT. EAST
#2 567 FT. NORTH & 400 FT. EAST
FROM P.O.B.

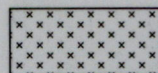

PLACE OF USE:
5.0 ACRES IRRIGATION IN THE
SW-SW Q.Q., SEC. 4, T.39S.,
R.3W., W.M.

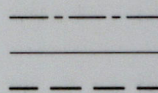

MAINLINE
TAXLOT BOUNDRIES
1/16TH SECTION LINES

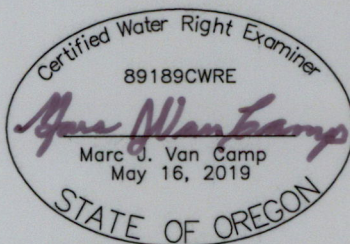

EXPIRES 06/30/2024

DISCLAIMER: THIS MAP WAS PREPARED FOR THE
PURPOSE OF IDENTIFYING THE LOCATION OF
WATER RIGHT ONLY AND IS NOT INTENDED TO
PROVIDE LEGAL DESCRIPTIONS OR LOCATIONS OF
PROPERTY LINES.

VCC

**VAN CAMP
CONSULTING**

P.O. Box 995
Coos Bay, OR 97420
(541) 297-1880
vancampconsulting@gmail.com

Prepared For:
Greg Brown
7368 HWY 238
Jacksonville, OR 97530

Project:
G-17449 Claim of
Beneficial Use

Date:
August 6, 2022