


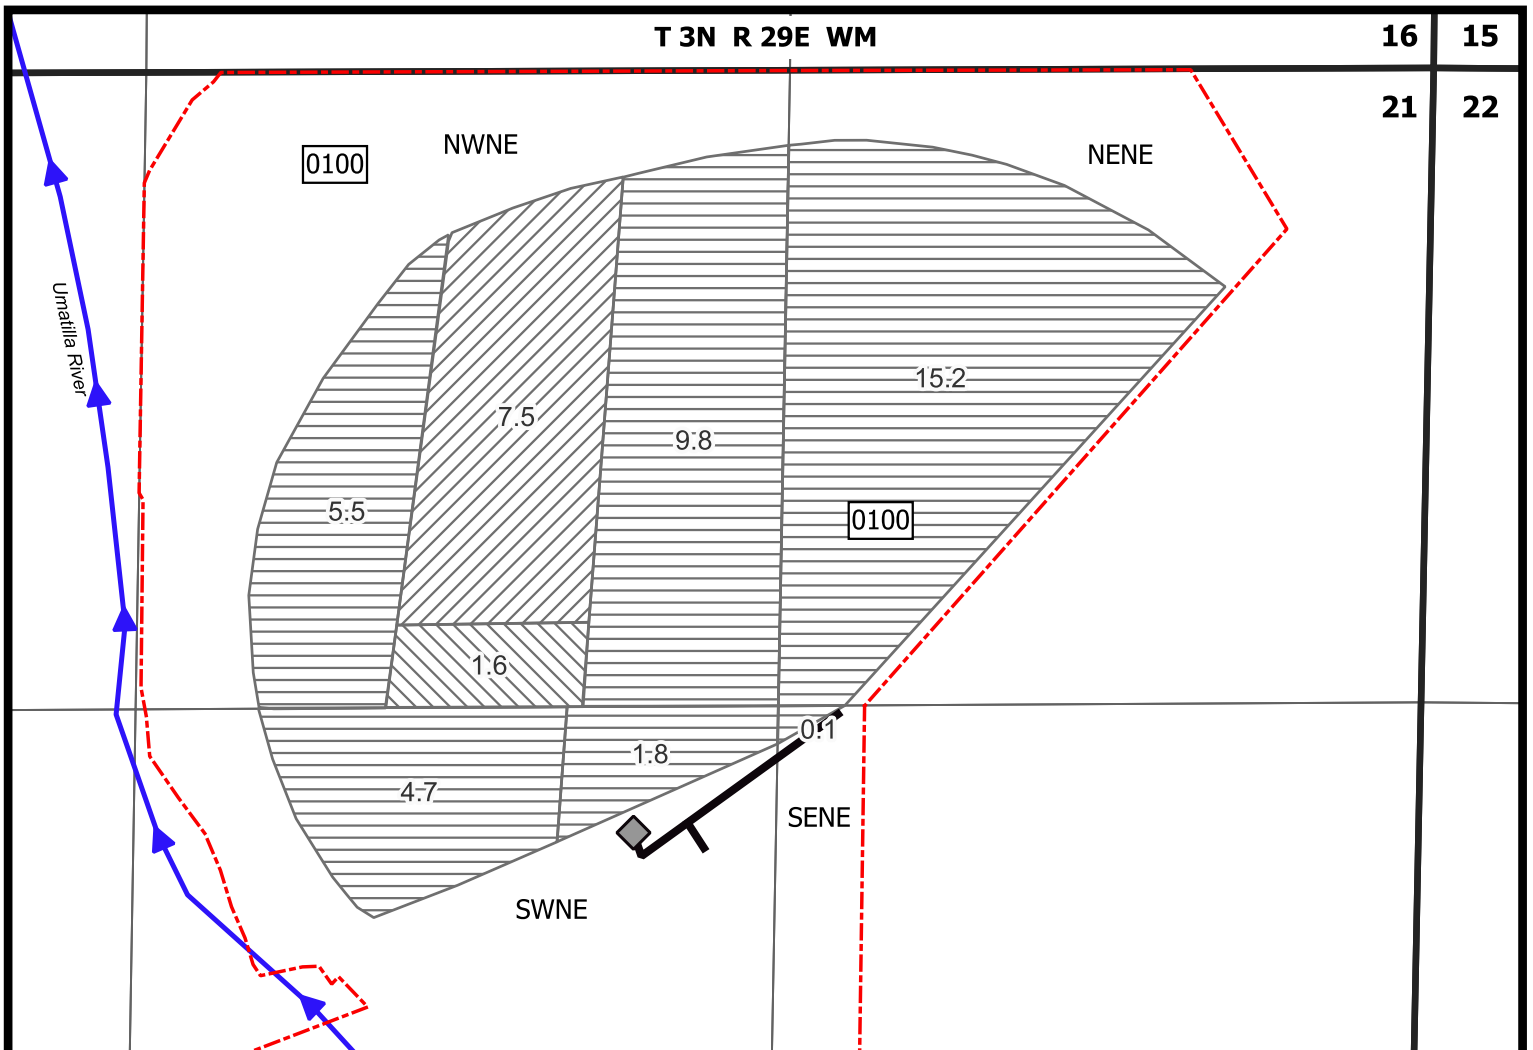

LEGEND

- 75453 (IR), 7400 (IS)
- 80979 (IR), 7400 (IS)
- 80983 (IR), 7400 (IS)
- Umatilla County Taxlot Boundary 0100
- Point of Diversion
- 8" mainline



Claim of Beneficial Use Map Transfer T-7919 Umatilla County, OR

Prepared on Behalf of John and Debbie McBee

1 inch = 400 feet



Notes:

Shallow Well: 1,367' S and 1,390' W from the NE Corner, Section 21

The flowmeter is located approximately 12' southeast of the POD

This map is not intended to provide legal dimensions or locations of property ownership lines.

Date: 4/17/2026
Drawn by: Paul F. Garvin