



T.2S. R.3E. Sec. 13 & 14, W.M.

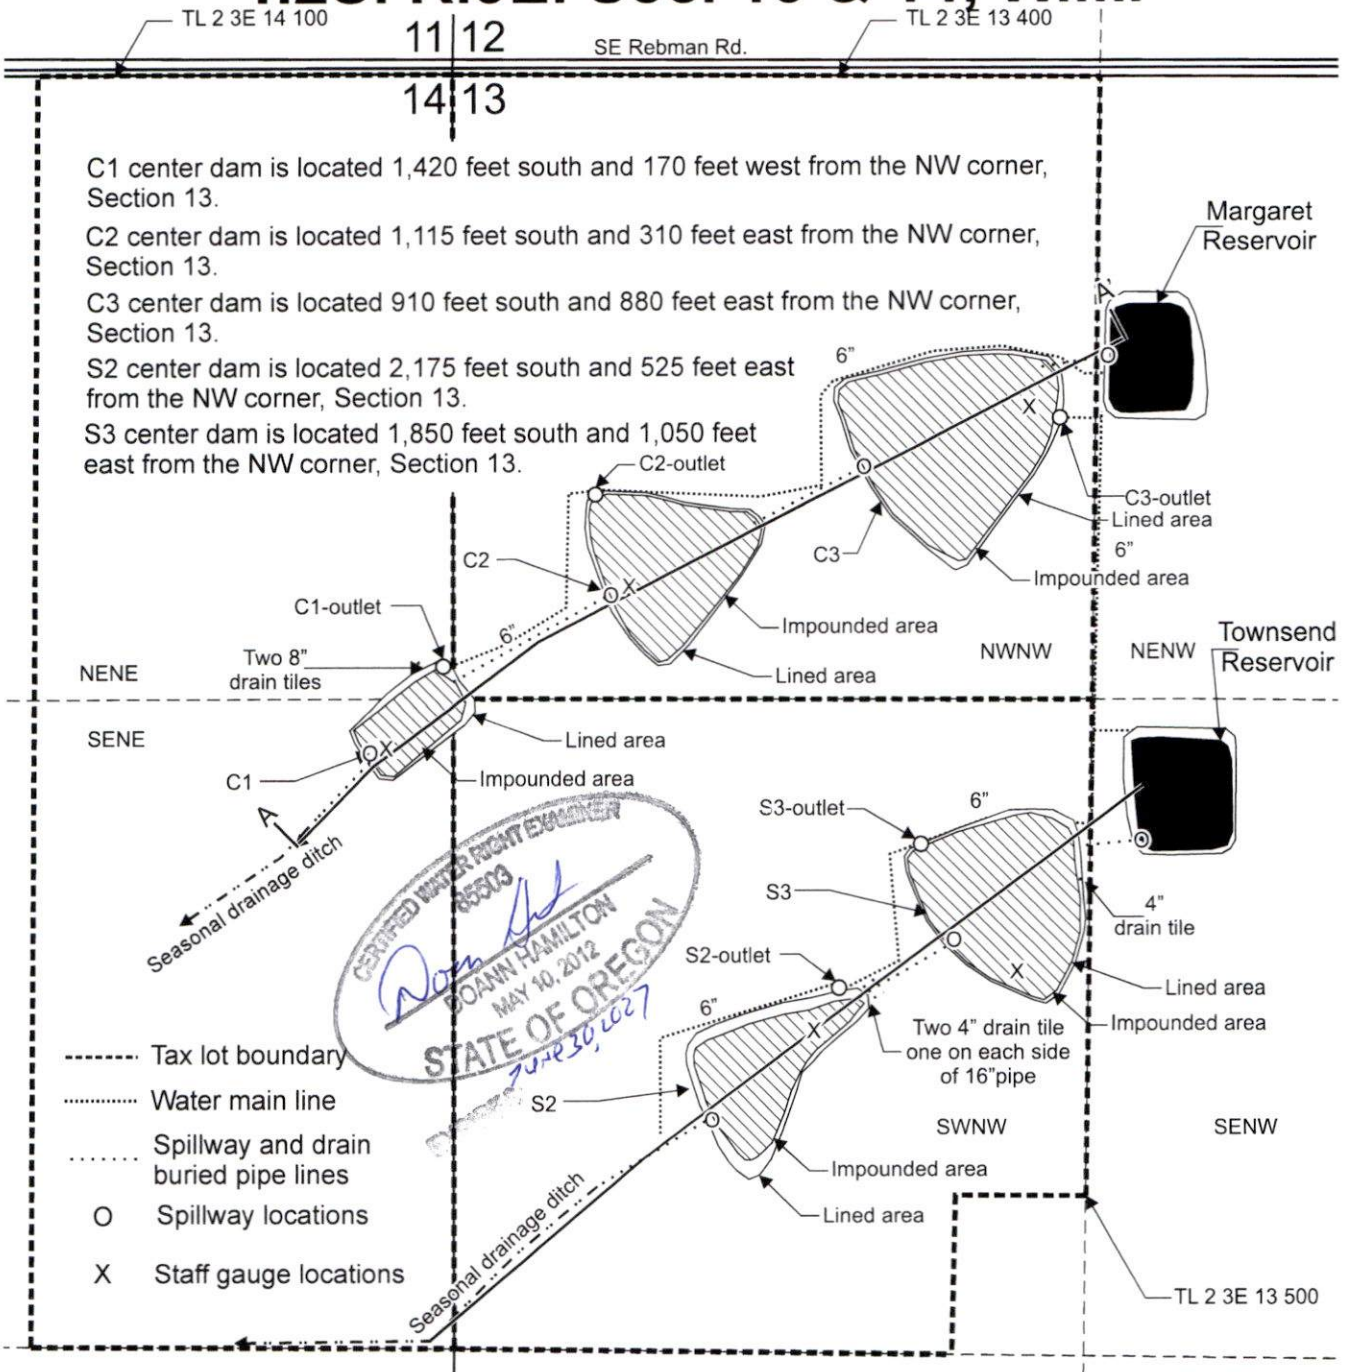

Reservoir Area (8.6 acre inundated) under Application R-88642, Permit R-15674 being:
 C1 (0.6 acre inundated), C2 (2.0 acre inundated), C3 (3.0 acre inundated),
 S2 (1.0 acre inundated) and S3 (2.0 acre inundated).

Scale: 1" = 400'

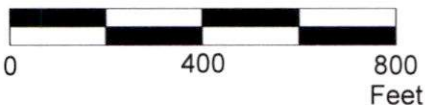

This map was prepared for the purpose of identifying the location of a water right only and is not intended to provide legal dimensions or location of property ownership lines.

Claim of Beneficial Use Map
 Application R-88642, Permit R-15674

Michael Townsend
 T.2S. R.3E. Sec. 13 & 14, W.M.

WILL MCGILL SURVEYING LLC

02/2026

Received by OWR

FEB 20 2026

Salem, OR