


**T23S R32.5E, WM
HARNEY COUNTY, OR**

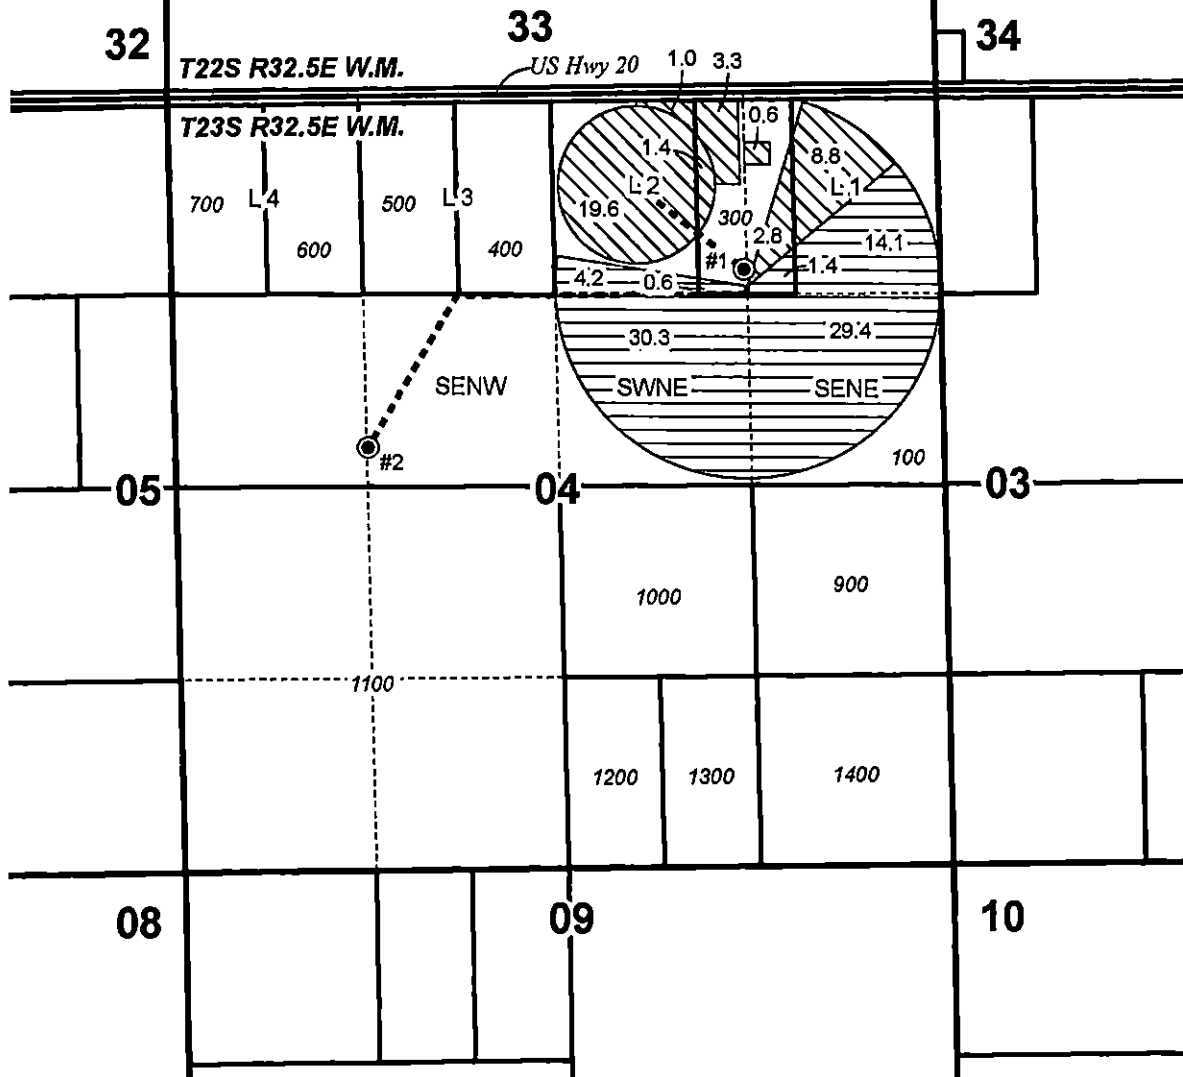

0 1,320
Feet

1" = 1320'



-  Well & Meter
 Pipeline
 POU IR 1/8/1981 Priority
 POU IR 7/3/1978 Priority
 Section
 Quarter Quarter
 Tax Lot

Well #1 (HARN 633 & HARN 52426 / L-118172):
1010' S, 1360' W of NE Cor Sec 4

Well #2 (HARN 52924 / L-136139)
270' N, 1320' W of Cen 1/4 Cor Sec 4



RENEWS: 06/30/2026



Claim of Beneficial Use Map

Kirby Isaac

Date: 5/16/2025

T-14153

**This map is not intended
to provide legal dimensions
or locations of property
ownership lines.**

WATER RIGHT SERVICES, LLC

PO BOX 1830, BEND, OR 97709

WWW.OREGONWATER.US CCB # 197121

johnshort@usa.com

541-389-2837