


CLAIM OF BENEFICIAL USE MAP


TO CHANGE PLACE OF USE FOR

APPLICATION T-12892

TAX LOTS: 100, 400, 600, & 700 IN SECTION 30,
 TAX LOTS: 100 & 200 IN SECTION 31,
 TAX LOT: 8500 IN SECTION 32,
 TOWNSHIP 24 SOUTH, RANGE 32.5 EAST, W.M.

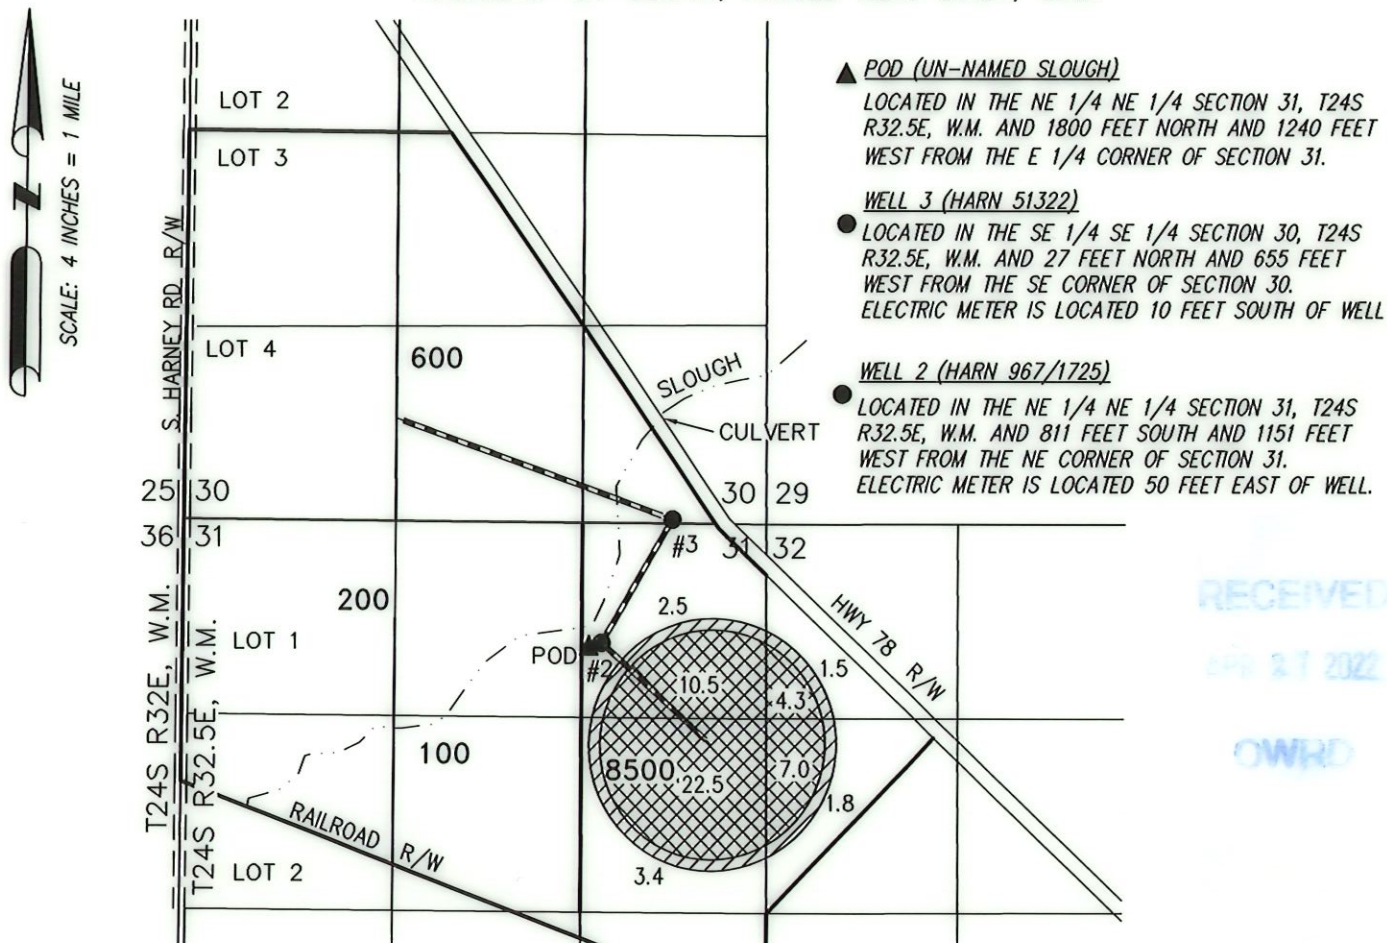

RECEIVED
 OWRD

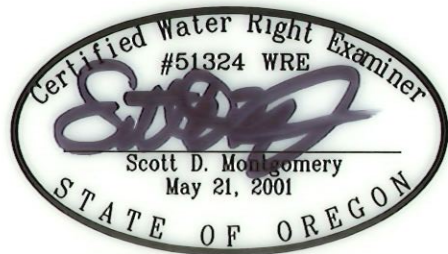

RENEWAL DATE: 12/31/2022



9.2 ACRES 'IR' RIGHTS FROM WELLS 3 & 4 (G-10512) & 'IS' RIGHTS FROM POD (S-49406) PER T-10437, AS SHOWN.



44.3 ACRES 'IR' FROM WELLS 3 & 4 PER T-10437 (G-10512), AS SHOWN.

THIS MAP IS FOR THE PURPOSE OF LOCATING A WATER RIGHT ONLY AND HAS NO INTENT TO PROVIDE LEGAL DIMENSIONS OR THE LOCATION OF PROPERTY LINES.

PREPARED FOR:

BLACKBURN RANCHES, LLC
 707 PONDEROSA VILLAGE
 BURNS, OR 97720

PREPARED BY:



ALL POINTS ENGINEERING AND SURVEYING, INC.
 P.O. BOX 767 TERREBONNE, OR 97760
 (541) 548-5833 www.APEandS.com