

RECEIVED BY OWRD

OCT 20 2014

SALEM, OR

NWNE

TL 2709

NENE

TL 2702

T 17 S, R 11 E
SECTION 15, WM

DESCHUTES COUNTY, OREGON



0 400
Feet
1" = 400'

TL 2710

SWNE

TL 2720

SENE


8

POND AND
BOOSTER PUMP

WELL & METER:
5.5' N, 383.3' W OF
CENTER EAST 1/16
CORNER SEC 15

15

- Section
- Quarter Quarter
- Taxlot
- Pond
- Well
- POU Irrigation

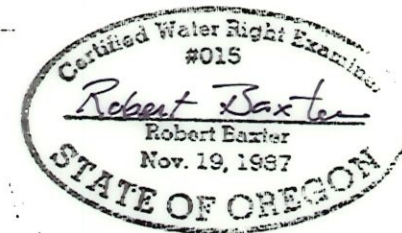

RENEWAL DATE 12/31/2015

CLAIM OF BENEFICIAL USE MAP
Tim and Jennifer Green

AP G-14178 PERMIT G-12755 T-11221

NOTE: THIS MAP IS NOT INTENDED TO
PROVIDE LEGAL DIMENSIONS OR LOCATIONS
OF PROPERTY OWNERSHIP LINES.

SEPTEMBER 26, 2014

WATER RIGHT SERVICES, LLC
PO BOX 1830, BEND, OR 97709
CCB# 197121 www.oregonwater.us
541-389-2837 JOHNSHORT@USA.COM