

CLAIM OF BENEFICIAL USE MAP


FOR TRANSFER APPLICATION T-13346

SECTION 34, TOWNSHIP 22 SOUTH, RANGE 33 EAST, W.M.


TAX LOT: 2200 AND

SECTION 3, TOWNSHIP 23 SOUTH, RANGE 33 EAST, W.M.

TAX LOTS: 400 AND 402

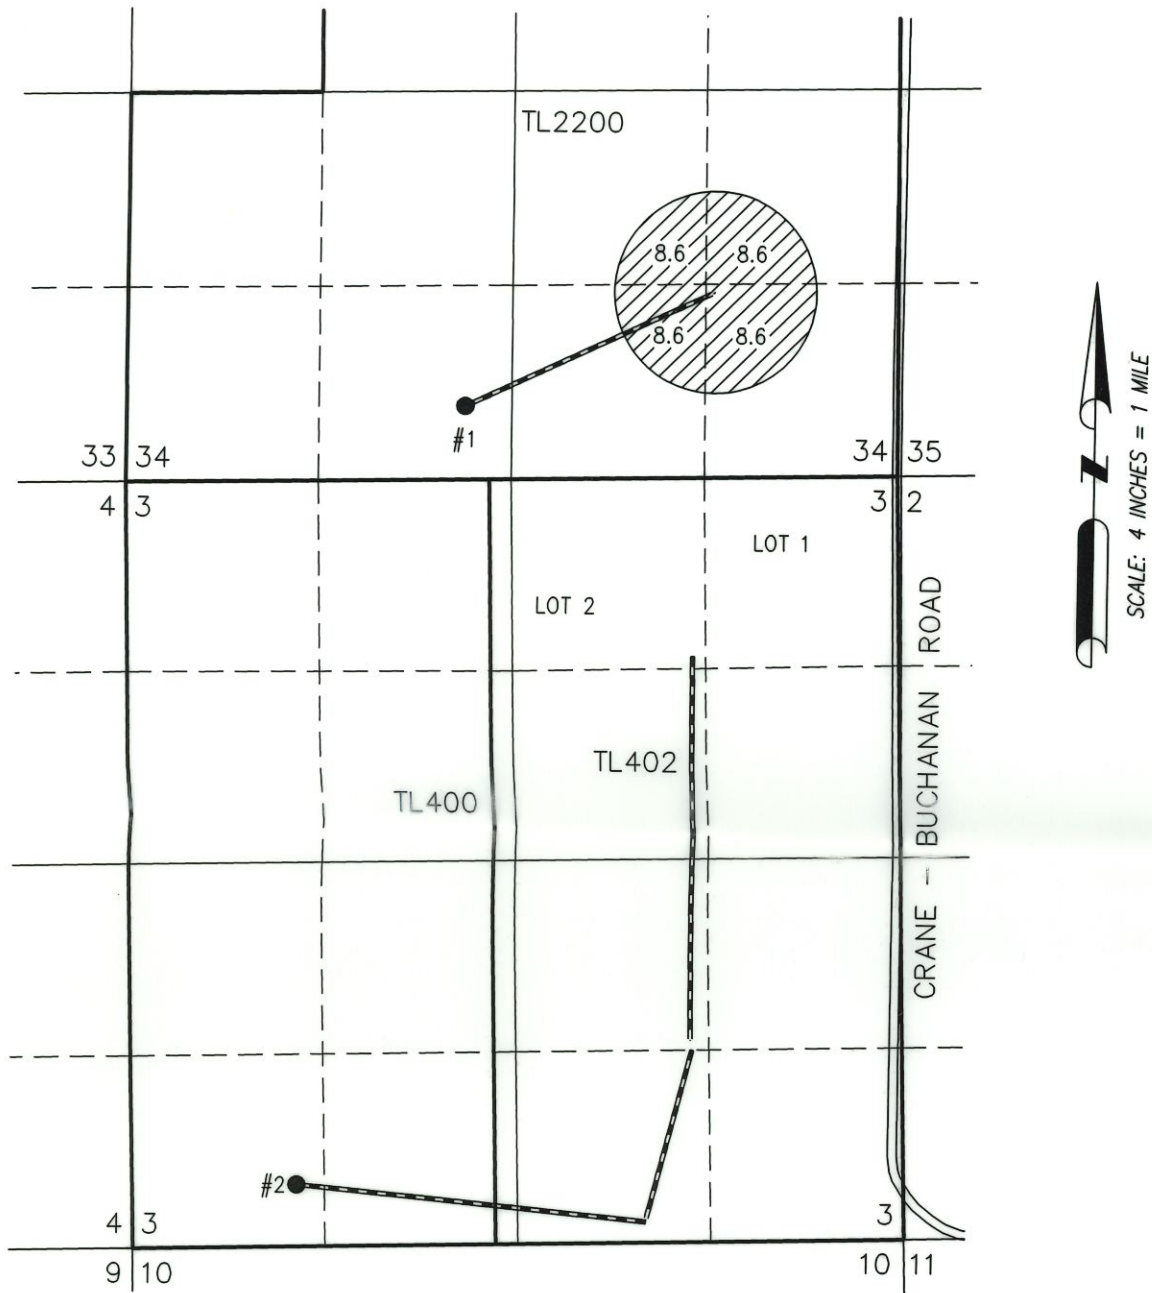

34.4 AC IS FROM PERMITS G-2343 & G-4330

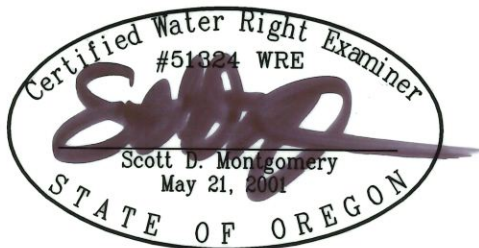

RENEWAL DATE: 12/31/2024

THIS MAP IS FOR THE PURPOSE OF
LOCATING A WATER RIGHT ONLY AND HAS
NO INTENT TO PROVIDE LEGAL DIMENSIONS
OR THE LOCATION OF PROPERTY LINES

- POA #1 (HARN 52029/52644)
LOCATED IN THE SE 1/4 SWE 1/4 SECTION 34, T22S R33E,
W.M. AND 500' N AND 2320' E FROM SW CORNER SECTION
34. FLOW METER LOCATED 5' EAST FROM WELL.

Received

JUN 13 2024

OWRD

BURIED CONDUIT

PREPARED FOR:

ANDY ROOT
524 HWY 20N
HINES, OR 97738

PREPARED BY:



ALL POINTS ENGINEERING AND SURVEYING, INC.
P.O. BOX 767 TERREBONNE, OR 97760
(541) 548-5833

www.APEandS.com