



CLAIM OF BENEFICIAL USE MAP
FOR TRANSFER APPLICATION T-13346

SECTION 34, TOWNSHIP 22 SOUTH, RANGE 33 EAST, W.M.
TAX LOT: 2200 AND
SECTION 3, TOWNSHIP 23 SOUTH, RANGE 33 EAST, W.M.
TAX LOTS: 400 AND 402

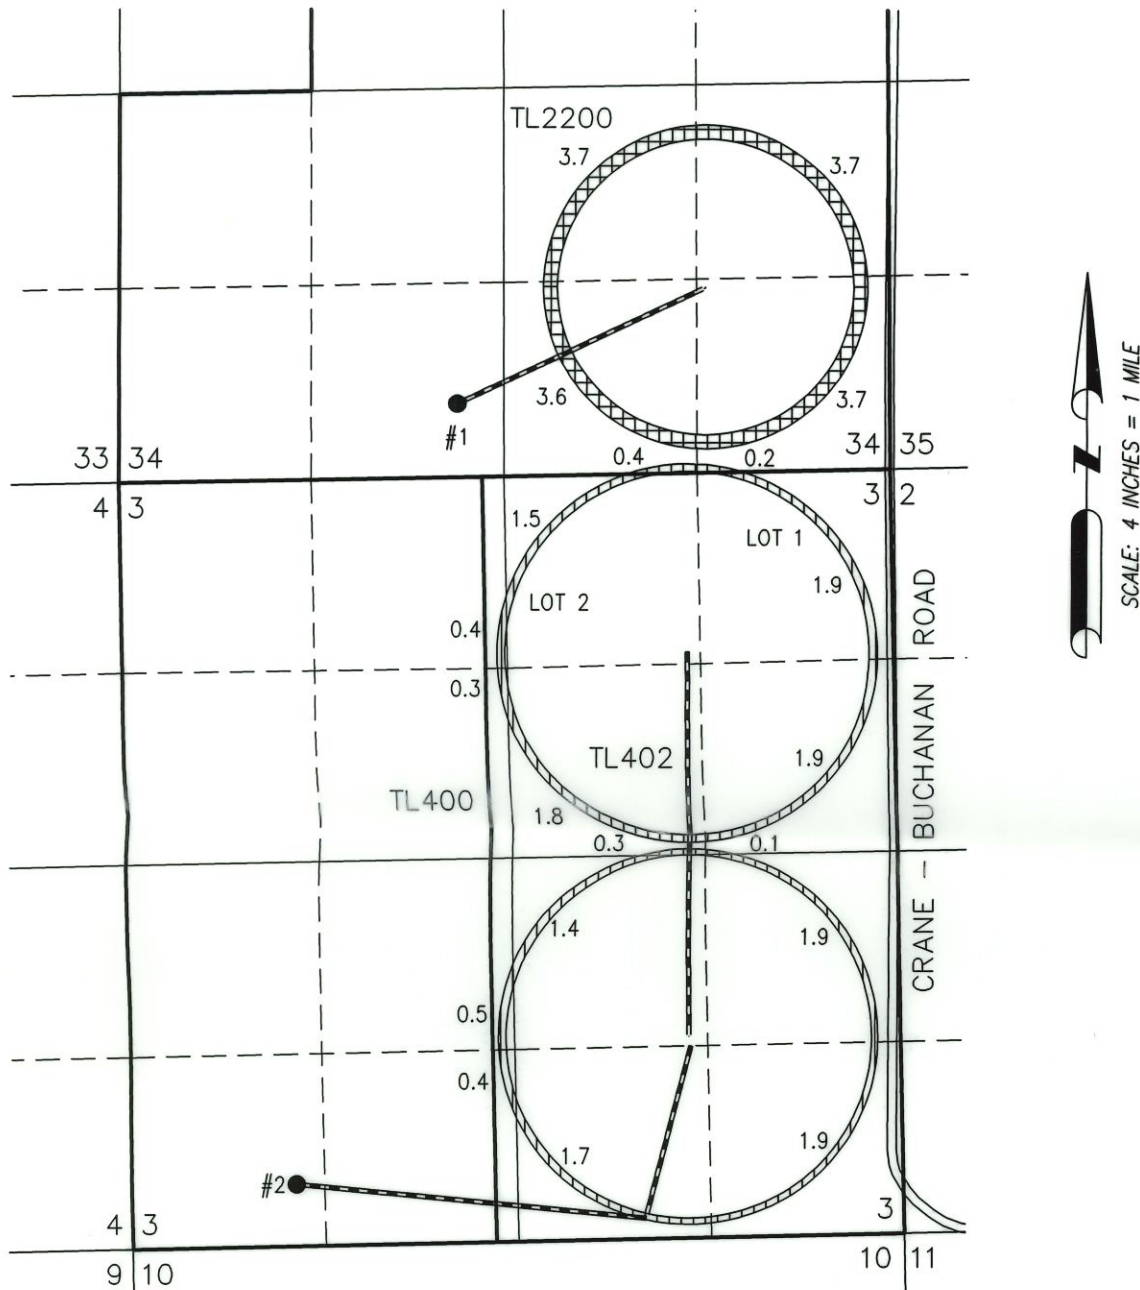

 16.6 AC IR FROM PERMIT G-7076
 14.7 AC IS FROM PERMIT G-7076

Received
JUN 13 2024
OWRD

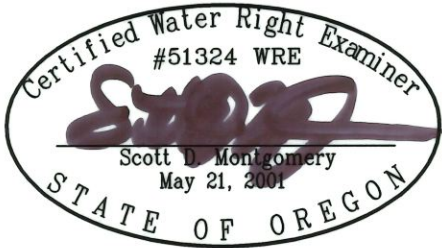

RENEWAL DATE: 12/31/2024

THIS MAP IS FOR THE PURPOSE OF
LOCATING A WATER RIGHT ONLY AND HAS
NO INTENT TO PROVIDE LEGAL DIMENSIONS
OR THE LOCATION OF PROPERTY LINES

- POA #1 (HARN 52029/52644)
LOCATED IN THE SE 1/4 SWE 1/4 SECTION 34, T22S R33E,
W.M. AND 500' N AND 2320' E FROM SW CORNER SECTION
34. FLOW METER LOCATED 5' EAST FROM WELL.
- POA #2 (HARN 52411)
LOCATED IN THE SE 1/4 SW 1/4 SECTION 3, T23S R33E,
W.M. AND 470' N AND 1660' E FROM SW CORNER SECTION 3.
FLOWMETER LOCATED 7' NE FROM WELL


BURIED CONDUIT

PREPARED FOR:

ANDY ROOT
524 HWY 20N
HINES, OR 97738

PREPARED BY:



ALL POINTS ENGINEERING AND SURVEYING, INC.
P.O. BOX 767 TERREBONNE, OR 97760
(541) 548-5833 www.APEandS.com