
All "From" and "To" acres are located within the Wm. S. Cooper D.L.C.

"From" Lands
Section 6
SESE: 13.3 acres

"To" Lands
Section 6
SESE: 1.94 acres
SWSE: 9.89 acres

"From" Lands
Taxlot 100: 12.98 acres
Taxlot 101: 0.10 acres
Taxlot 102: 0.23 acres

"To" Lands
Taxlot 100: 11.7 acres
Taxlot 102: 0.13 acres

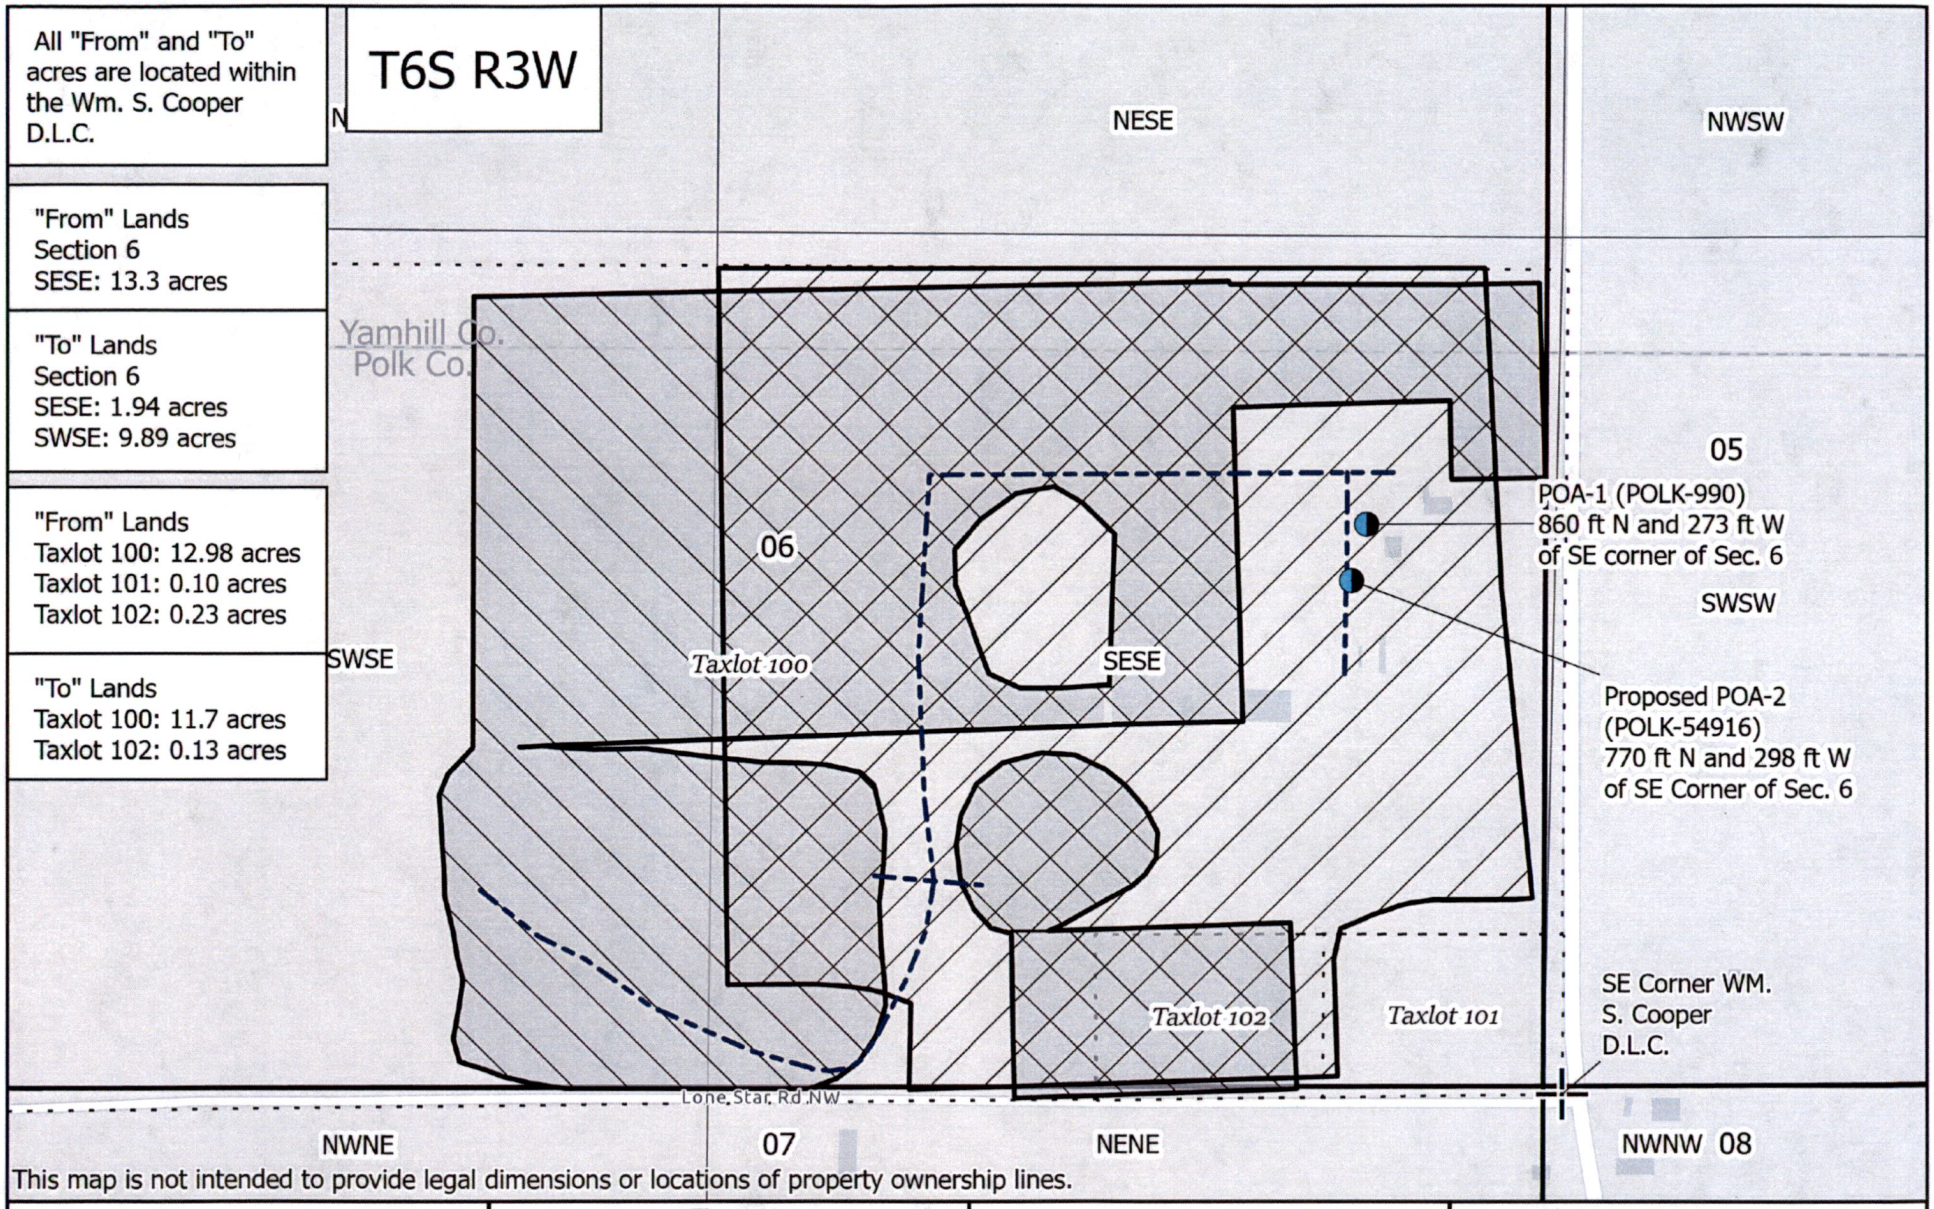

This map is not intended to provide legal dimensions or locations of property ownership lines.

EVREN NORTHWEST INC.
environmental, geotechnical, natural resource consultants

EVREN Northwest Environmental, Inc.
PO Box 14488
Portland, OR 97293


Figure 1
GR-139 Modification Map
Priority Date: 10/31/1952
Use: Irrigation and Domestic

No.	Date	By	Revisions
1	DATE	AUTH	DRAFT

N
0 250 500 Feet
1:4,800

- POA
- Distribution Lines
- Taxlot Boundaries
- Proposed POU (Irrigation and Domestic)
- GR-139 POU
- Unchanged POU

Received by OWRD
JUL 01 2024
Salem, OR
14491 -

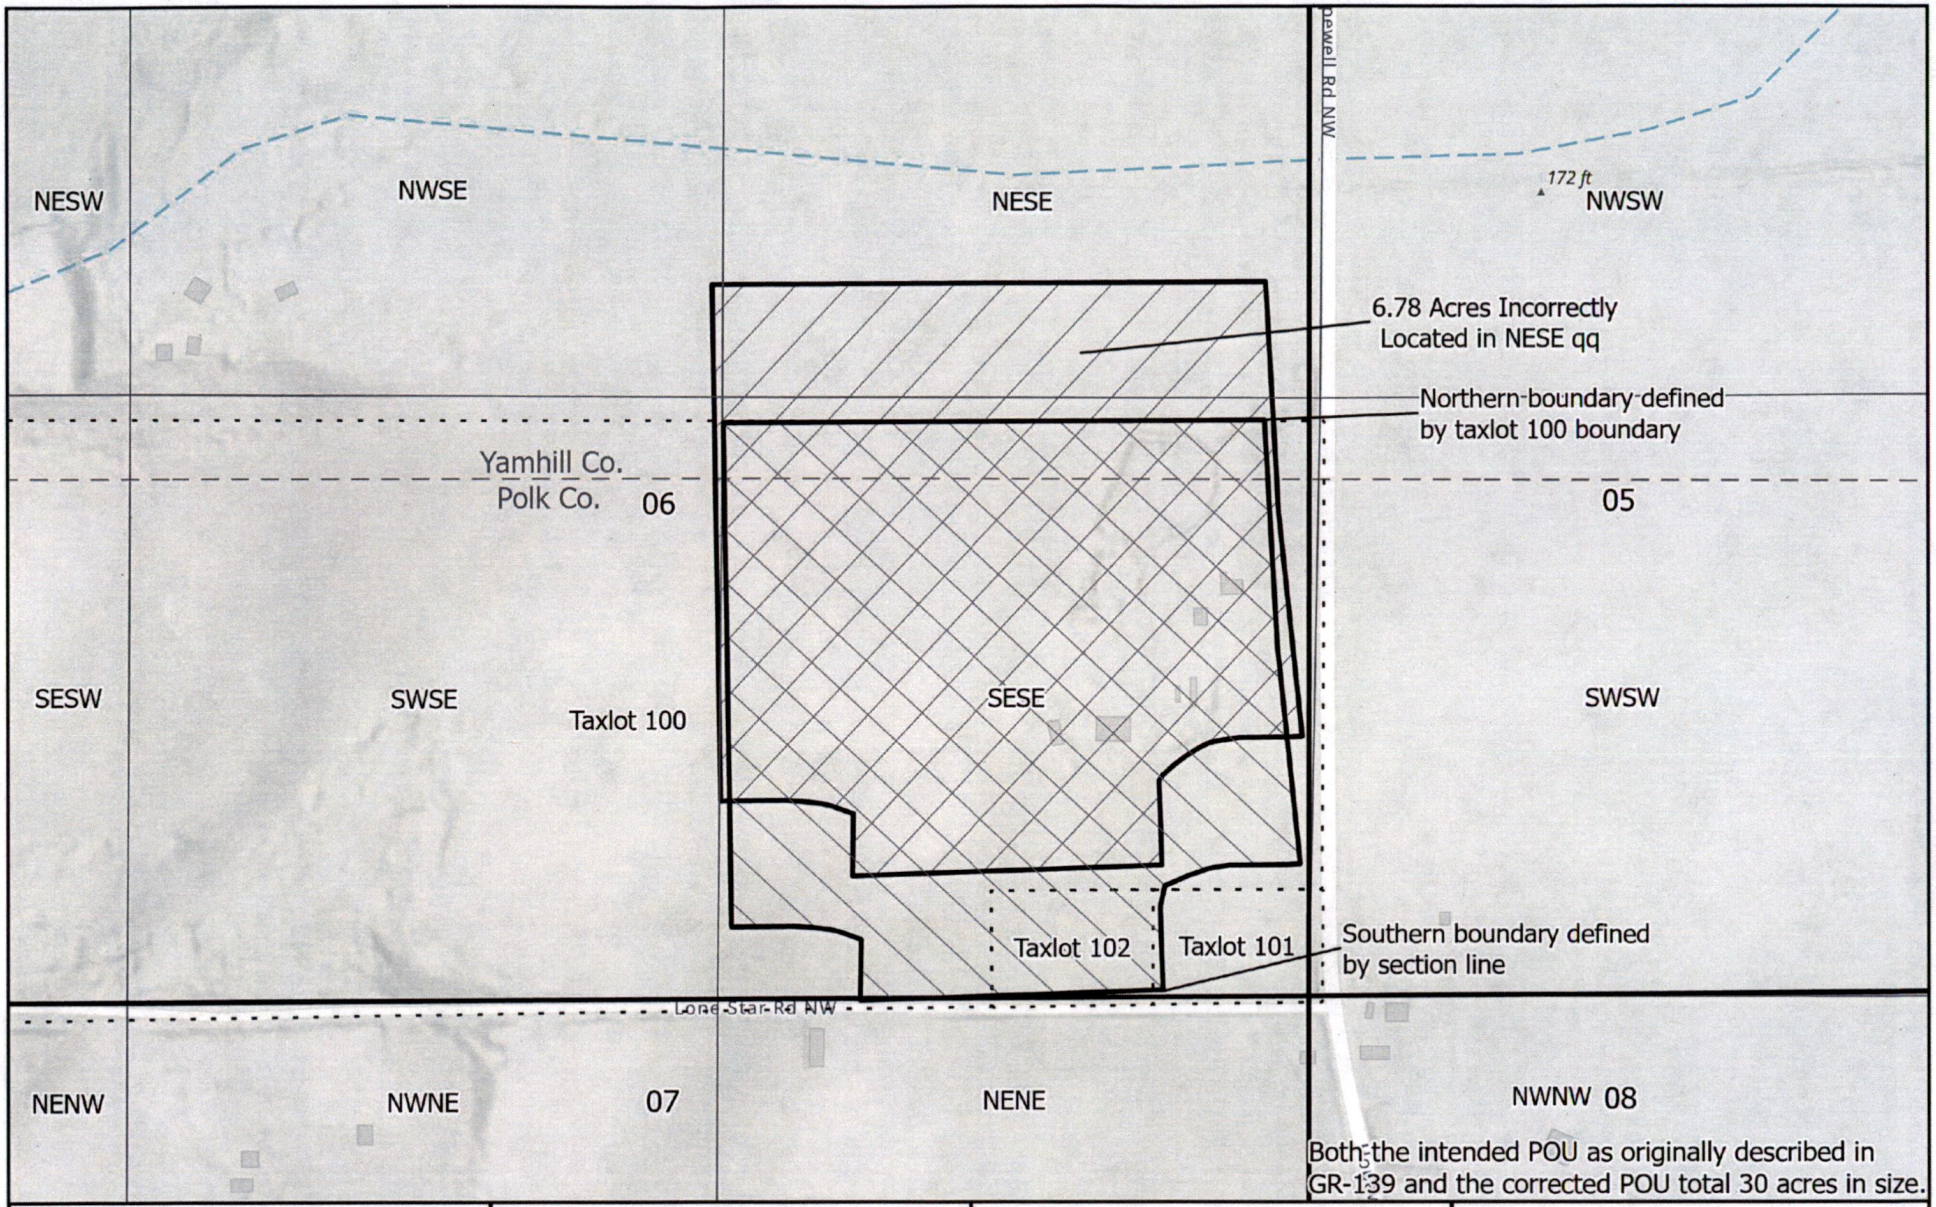

EVREN NORTHWEST INC.
environmental, geotechnical, natural resource consultants

EVREN Northwest Environmental, Inc.
PO Box 14488
Portland, OR 97293

Attachment 1
GR-139 POU Correction Map

No.	Date	By	Revisions
1	DATE	AUTH	DRAFT

N


0 250 500 Feet
1:4,800

OWRD Database POU
Corrected POU
Taxlot Boundaries

Received by OWRD
JUL 01 2024
Salem, OR

14491 -

T.4,5 & 6 S., R.3W., W.M.

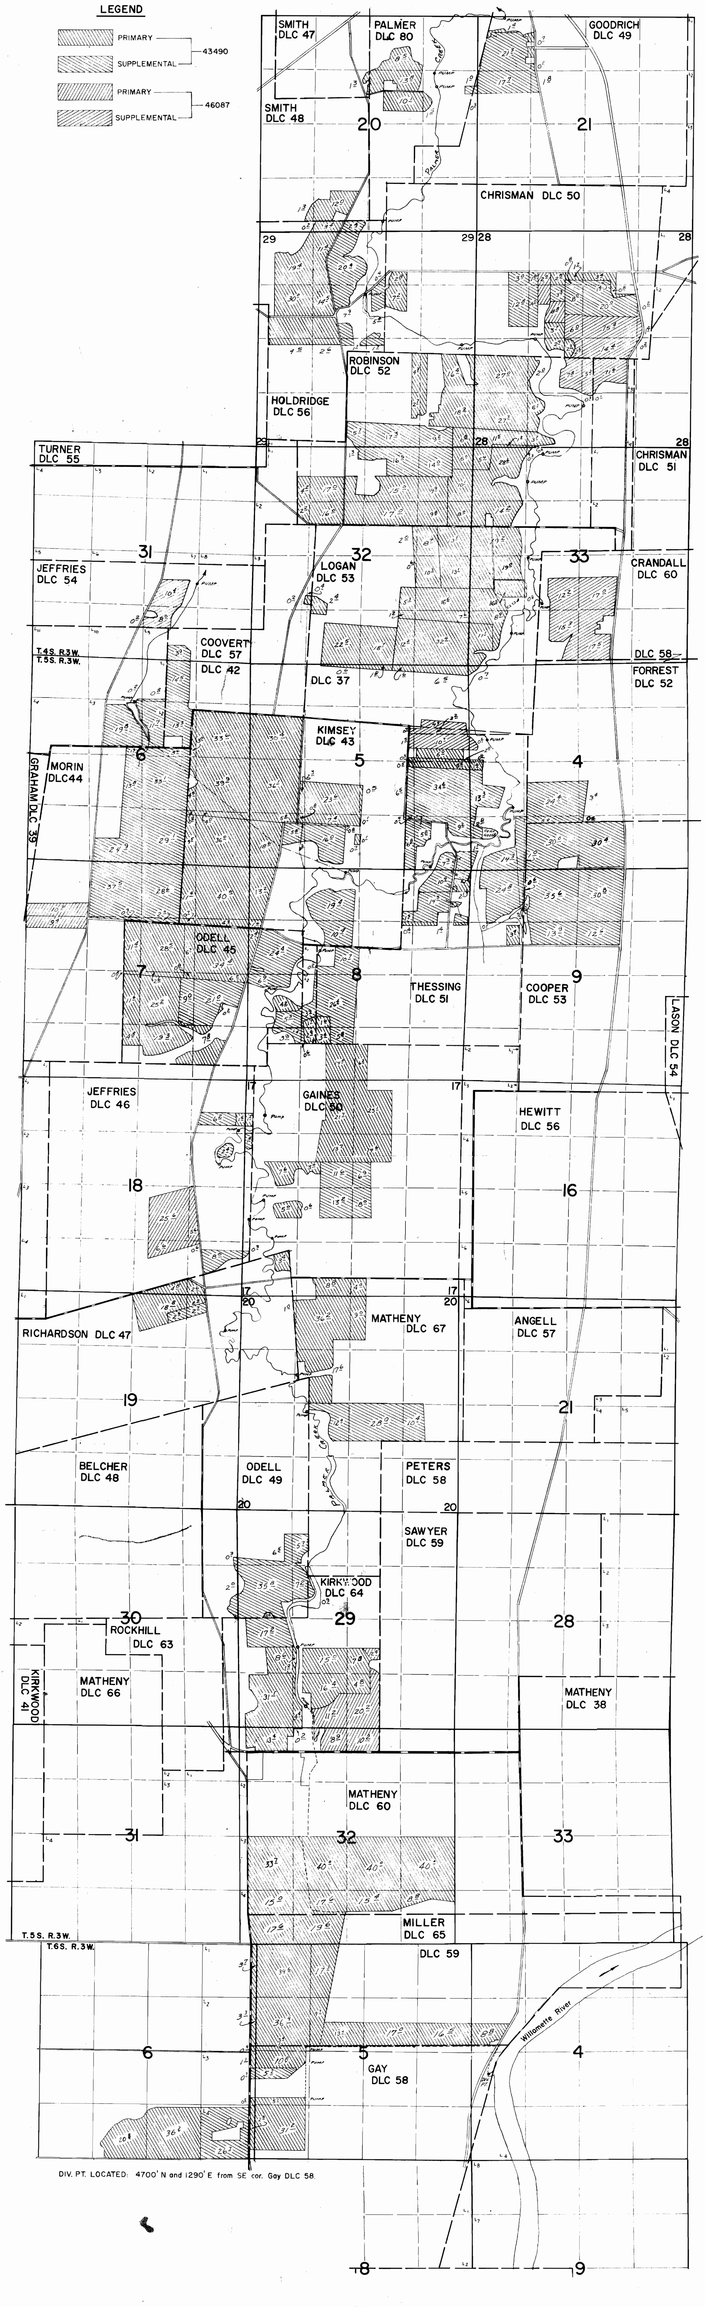


FINAL PROOF SURVEY

43490 32243
Application No. 46087 Permit No. 34436
IN NAME OF
PALMER CREEK WATER DISTRICT IMPROVEMENT COMPANY

Aug. 12-15, 1975 L.E. Gould
Aug. 21-23, 1975 R.G. Mucken
Surveyed Aug. 26-29, 1975, by D.M. Norby

RECEIVED
DEC 22 2017
OWRD

T.5S. R.3W. Sec. 3, 4, 9, 10, and 16 W.M.

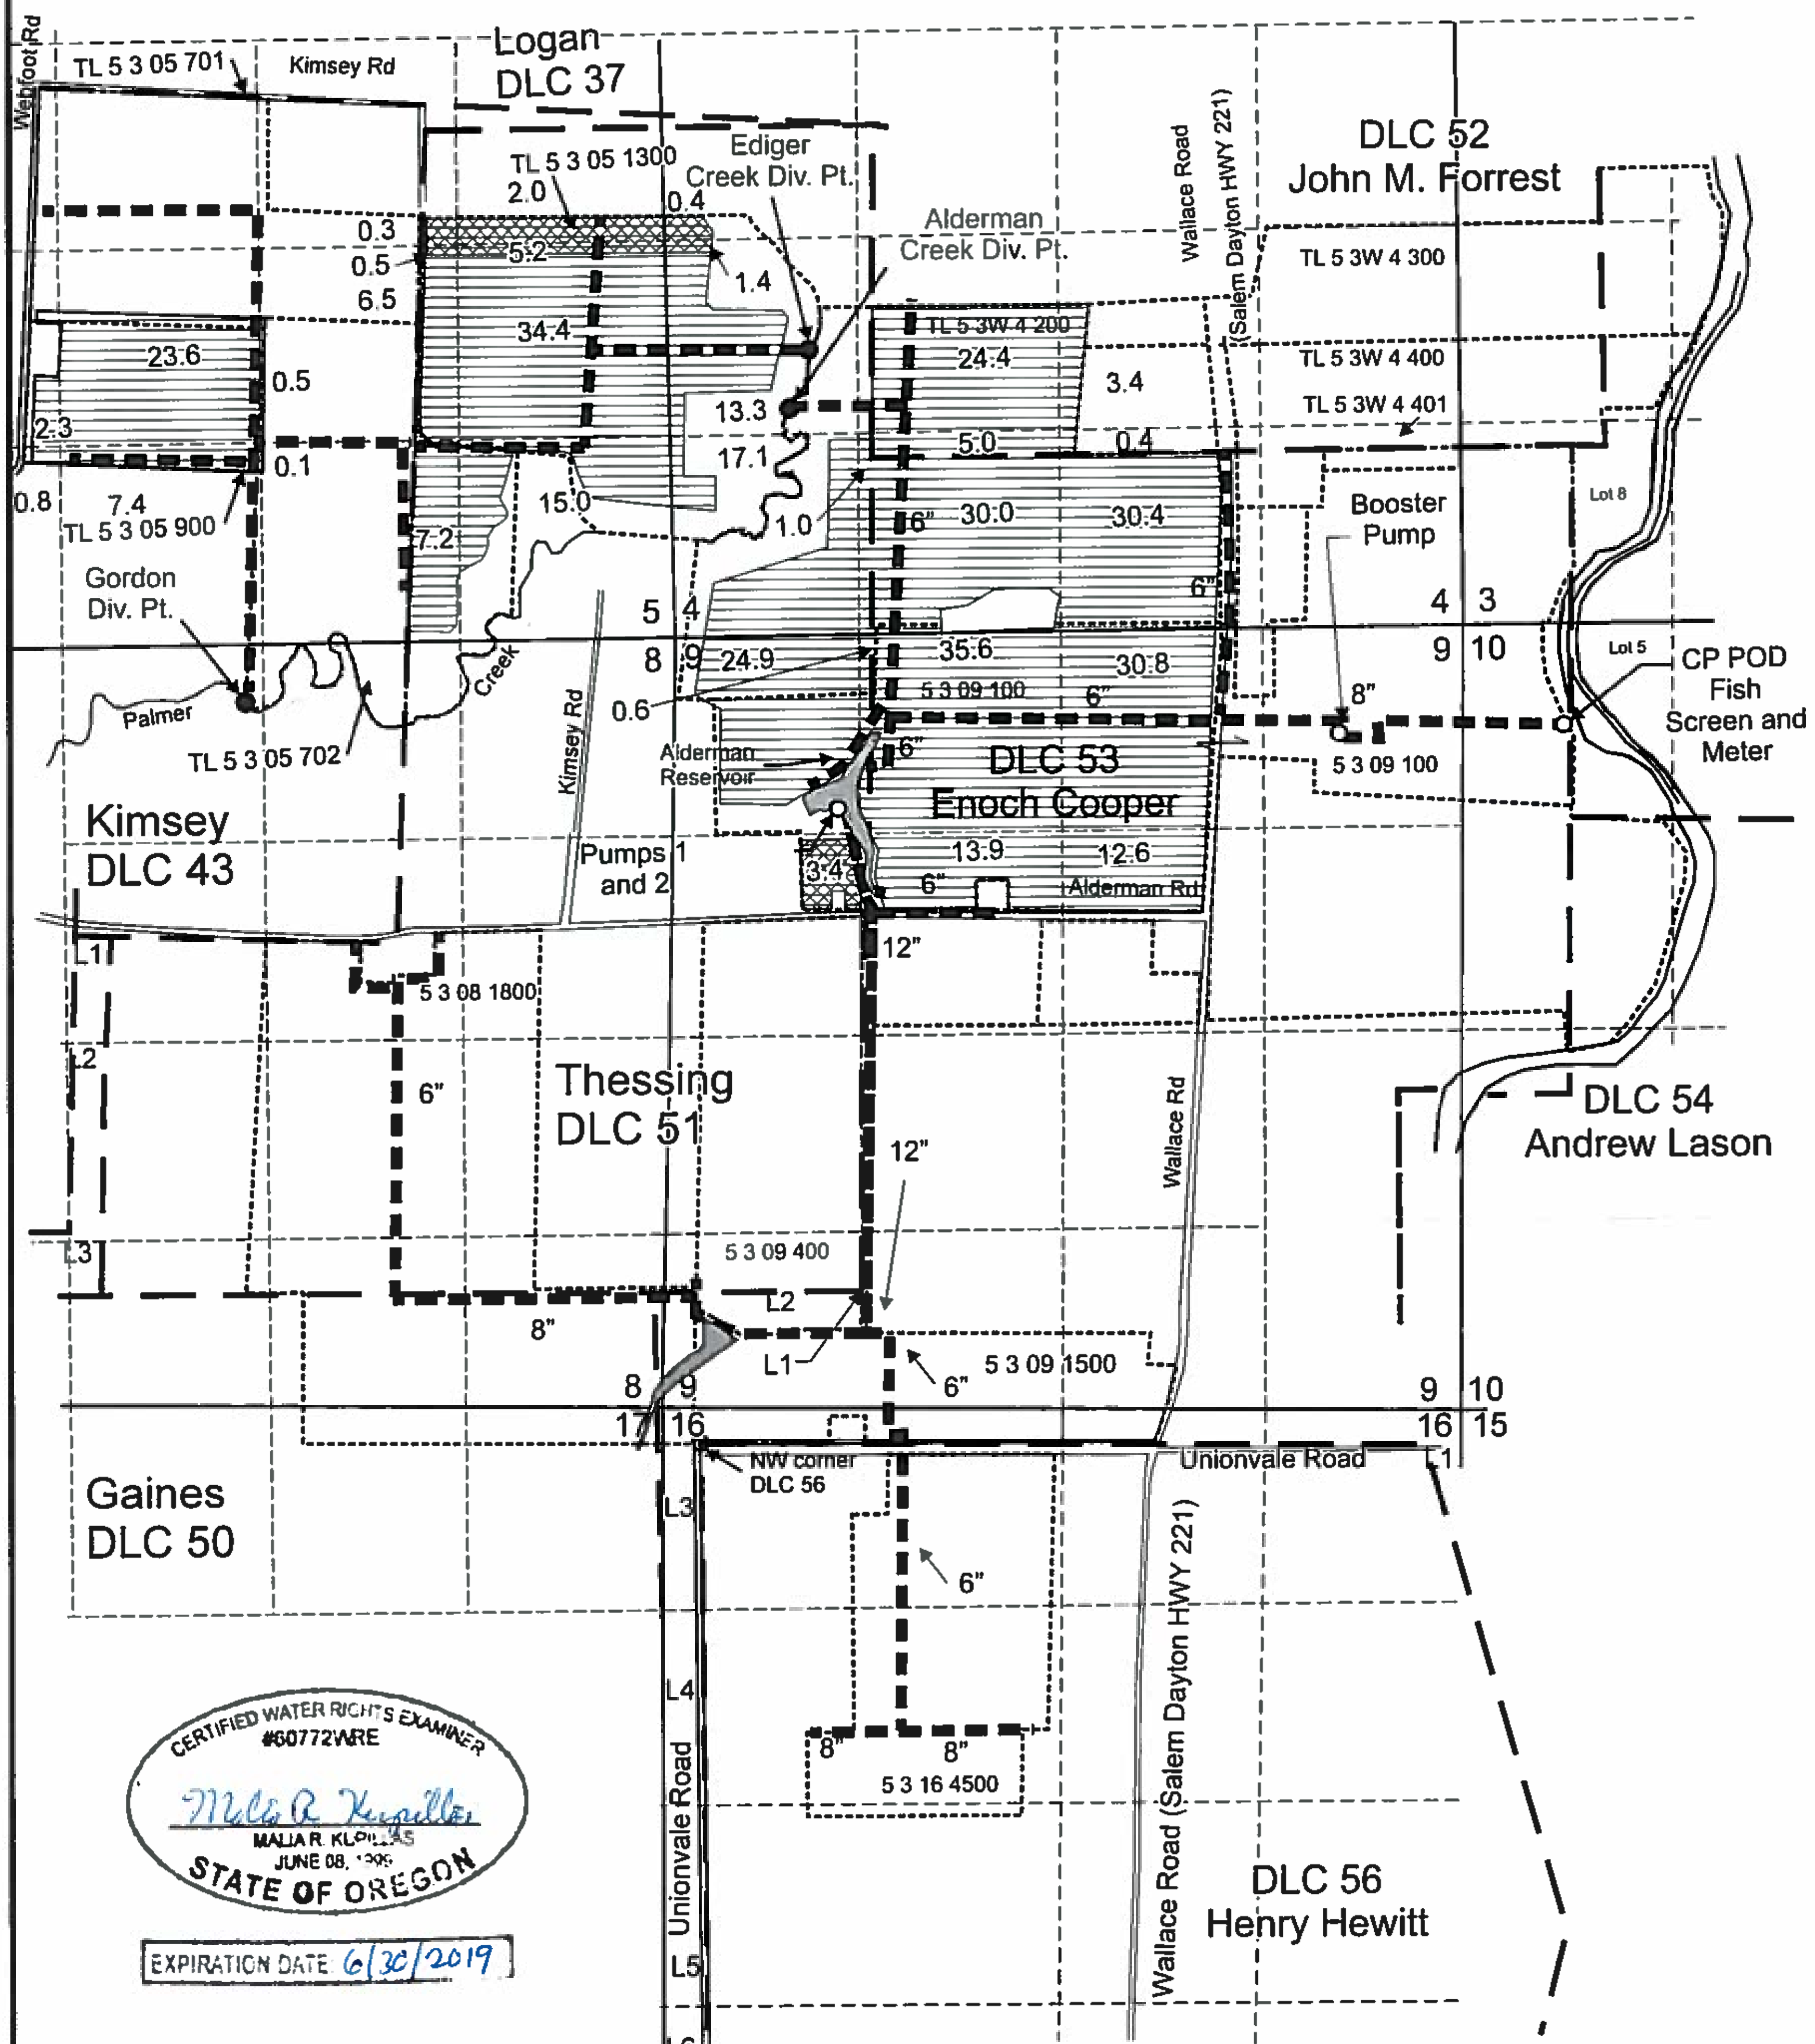

CERTIFIED WATER RIGHTS EXAMINER
#60772WRE
MALIA R. KUPILLAS
JUNE 08, 1999
STATE OF OREGON
EXPIRATION DATE 6/30/2019

Area (47.9 Acres primary) to be irrigated with additional POD.

Area (306.5 Acres supplemental) to be irrigated with additional POD.

o Point of Diversion (CP POD) is located 608 feet north and 40 feet west from the Northerly NW Corner of DLC 54

6-inch, 8-inch and 12-inch buried PVC mainline

Scale: 1" = 1,320'

0 1,320 Feet

This map was prepared for the purpose of identifying the location of a water right only and is not intended to provide legal dimensions or location of property ownership lines.

Pacific Hydro-Geology Inc.

Transfer Map 1. Additional POD
Priority 4/14/1967, Certificate 64748

Carlton Nursery Co., LLC
2016 - mrk T.5S. R.3W. Sec. 3, 4, 9, 10 and 16, W.M.

AldermanMainline.cdr

T 12798