
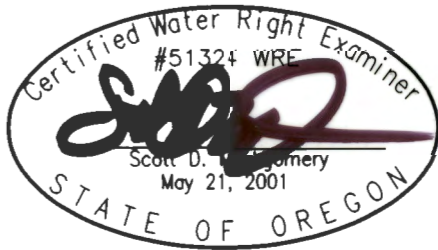


CLAIM OF BENEFICIAL USE MAP

TO CHANGE PLACE OF USE AND
POINTS OF DIVERSION
FOR APPLICATION T-12934
WILLIAM AND JACKIE DUNBAR

TOWNSHIP 22 SOUTH, RANGE 30 EAST, SECTION 9, W.M.
TAX LOT: 800 HARNEY COUNTY, OREGON

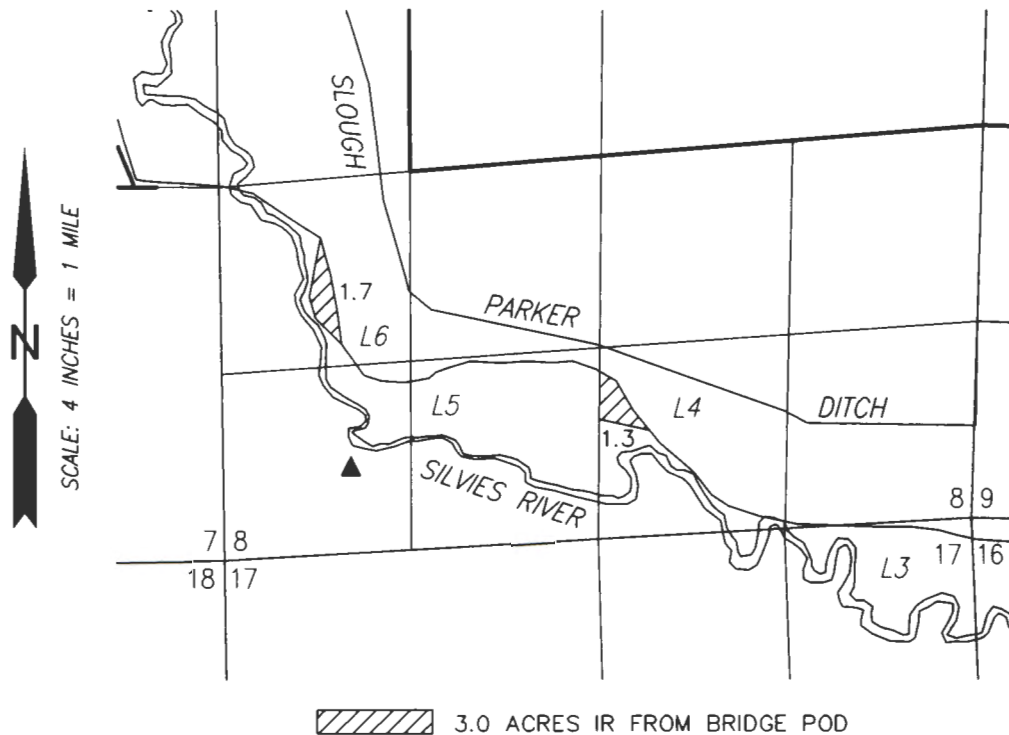

RENEWAL DATE: 12/31/2024

THIS MAP IS FOR THE PURPOSE OF LOCATING A WATER
RIGHT ONLY AND HAS NO INTENT TO PROVIDE LEGAL
DIMENSIONS OR THE LOCATION OF PROPERTY LINES

▲ POD BRIDGE
WET WELL 12" Ø STEEL
580' NORTH & 875' EAST FROM THE SW
CORNER SECTION 8

FLOW METER IS LOCATED ON DELIVERY PIPE,
±3' WEST FROM POD.

Received

JUL 29 2024

OWRD

PREPARED FOR:

WILLIAM DUNBAR
9622 VICTOR ROAD
ANCHORAGE, AK 99516

PREPARED BY:



ALL POINTS ENGINEERING AND SURVEYING, INC.
P.O. BOX 767 TERREBONNE, OR 97760
(541) 548-5833 www.APEandS.com