CLAIM OF BENEFICIAL USE MAP

TO CHANGE POINT OF APPROPRIATION AND PLACE OF USE FOR TRANSFER APPLICATION T-14399

SECTIONS 5 & 6, TOWNSHIP 27 SOUTH, RANGE 34 EAST, W.M.
TAX LOT: 601 & 700

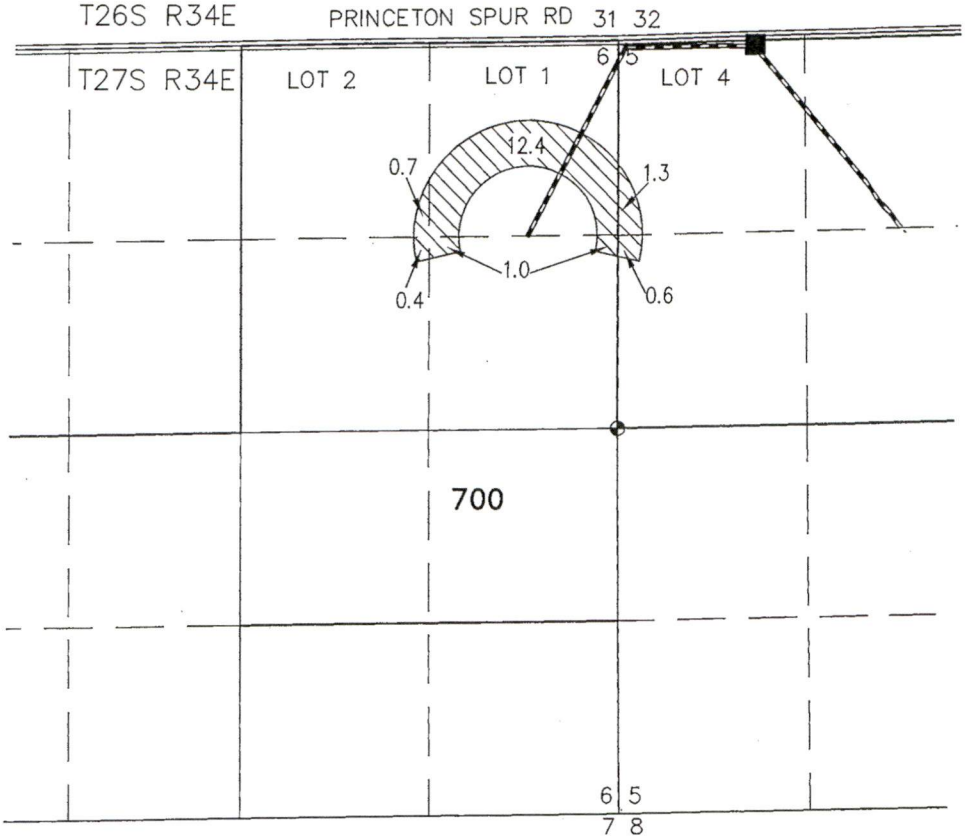

Received by OWRD
JUN 22 2026
Salem, OR

■ BUFFALO WELL 43°15'42.58" N & 118°33'36.58" W (HARN 50318) LOCATED 35 FEET SOUTH AND 975 FEET EAST FROM THE NW CORNER OF SECTION 5. FLOW METER IS 6.5 FEET SOUTH FROM WELL.

BURIED 6 OR 8 INCH STEEL PIPE

THIS MAP IS FOR THE PURPOSE OF LOCATING A WATER RIGHT ONLY AND HAS NO INTENT TO PROVIDE LEGAL DIMENSIONS OR THE LOCATION OF PROPERTY LINES

16.4 ACRES 'IR' FROM CERTIFICATE 97231 (PERMIT G-12961), PER T-14399, AS SHOWN.

Certified Water Right Examiner
#51324 WRE
Scott D. Montgomery
May 21, 2001
STATE OF OREGON

RENEWAL DATE: 12/31/2026

PREPARED FOR:	PREPARED BY:
JIM AND SUE GILMOUR 30427 STELLMACHER DRIVE ALBANY, OR 97321	ALL POINTS ENGINEERING AND SURVEYING, INC. P.O. BOX 767 TERREBONNE, OR 97760 (541) 548-5833 www.APEandS.com