


CLAIM OF BENEFICIAL USE MAP

TO CHANGE POINT OF APPROPRIATION AND PLACE OF USE
FOR TRANSFER APPLICATION T-14227

SECTIONS 5 & 6, TOWNSHIP 27 SOUTH, RANGE 34 EAST, W.M.
TAX LOT: 601 & 700

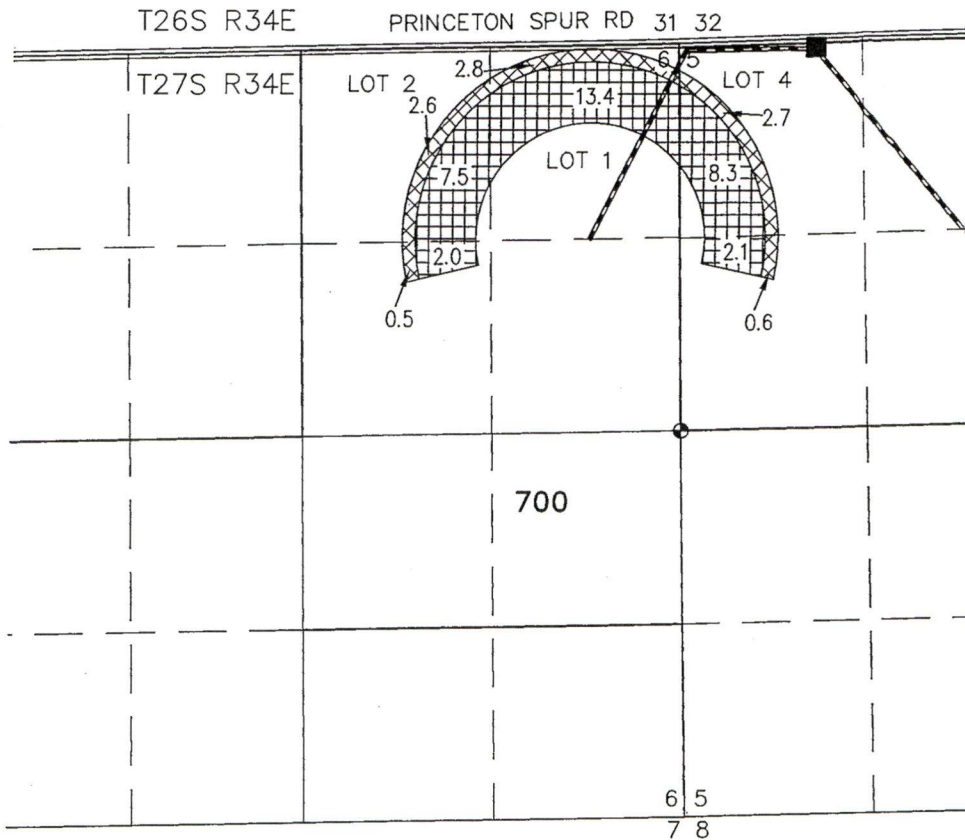


Received by OWRD
JUN 22 2026
Salem, OR

BUFFALO WELL 43°15'42.58" N & 118°33'36.58" W
(HARN 50318) LOCATED 35 FEET SOUTH AND 975
FEET EAST FROM THE NW CORNER OF SECTION 5.
FLOW METER IS 6.5 FEET SOUTH FROM WELL.

BURIED 6 OR 8 INCH STEEL PIPE

THIS MAP IS FOR THE PURPOSE OF LOCATING A WATER
RIGHT ONLY AND HAS NO INTENT TO PROVIDE LEGAL
DIMENSIONS OR THE LOCATION OF PROPERTY LINES

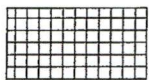


33.3 ACRES 'IR' FROM CERTIFICATE 91034
(PERMIT G-15663), PER T-14227, AS SHOWN.



9.2 ACRES 'IR' FROM CERTIFICATE 96822
(PERMIT G-18086), PER T-14227, AS SHOWN.

Scott D
Montgomery

Digitally signed by Scott D Montgomery
DN: cn=Scott D Montgomery, o=All
Points Engineering and Surveying, Inc.,
ou=email=scott@apeands.com, c=US
Date: 2026.06.22 14:25:48 -0700

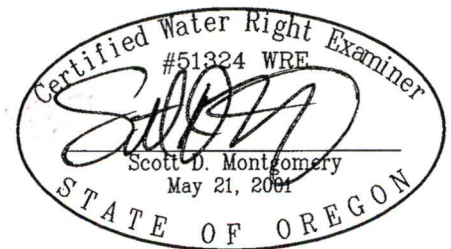

RENEWAL DATE: 12/31/2026

PREPARED FOR:

JIM AND SUE GILMOUR
30427 STELLMACHER DRIVE
ALBANY, OR 97321

PREPARED BY:



ALL POINTS ENGINEERING AND SURVEYING, INC.
P.O. BOX 767 TERREBONNE, OR 97760
(541) 548-5833 www.APEandS.com