


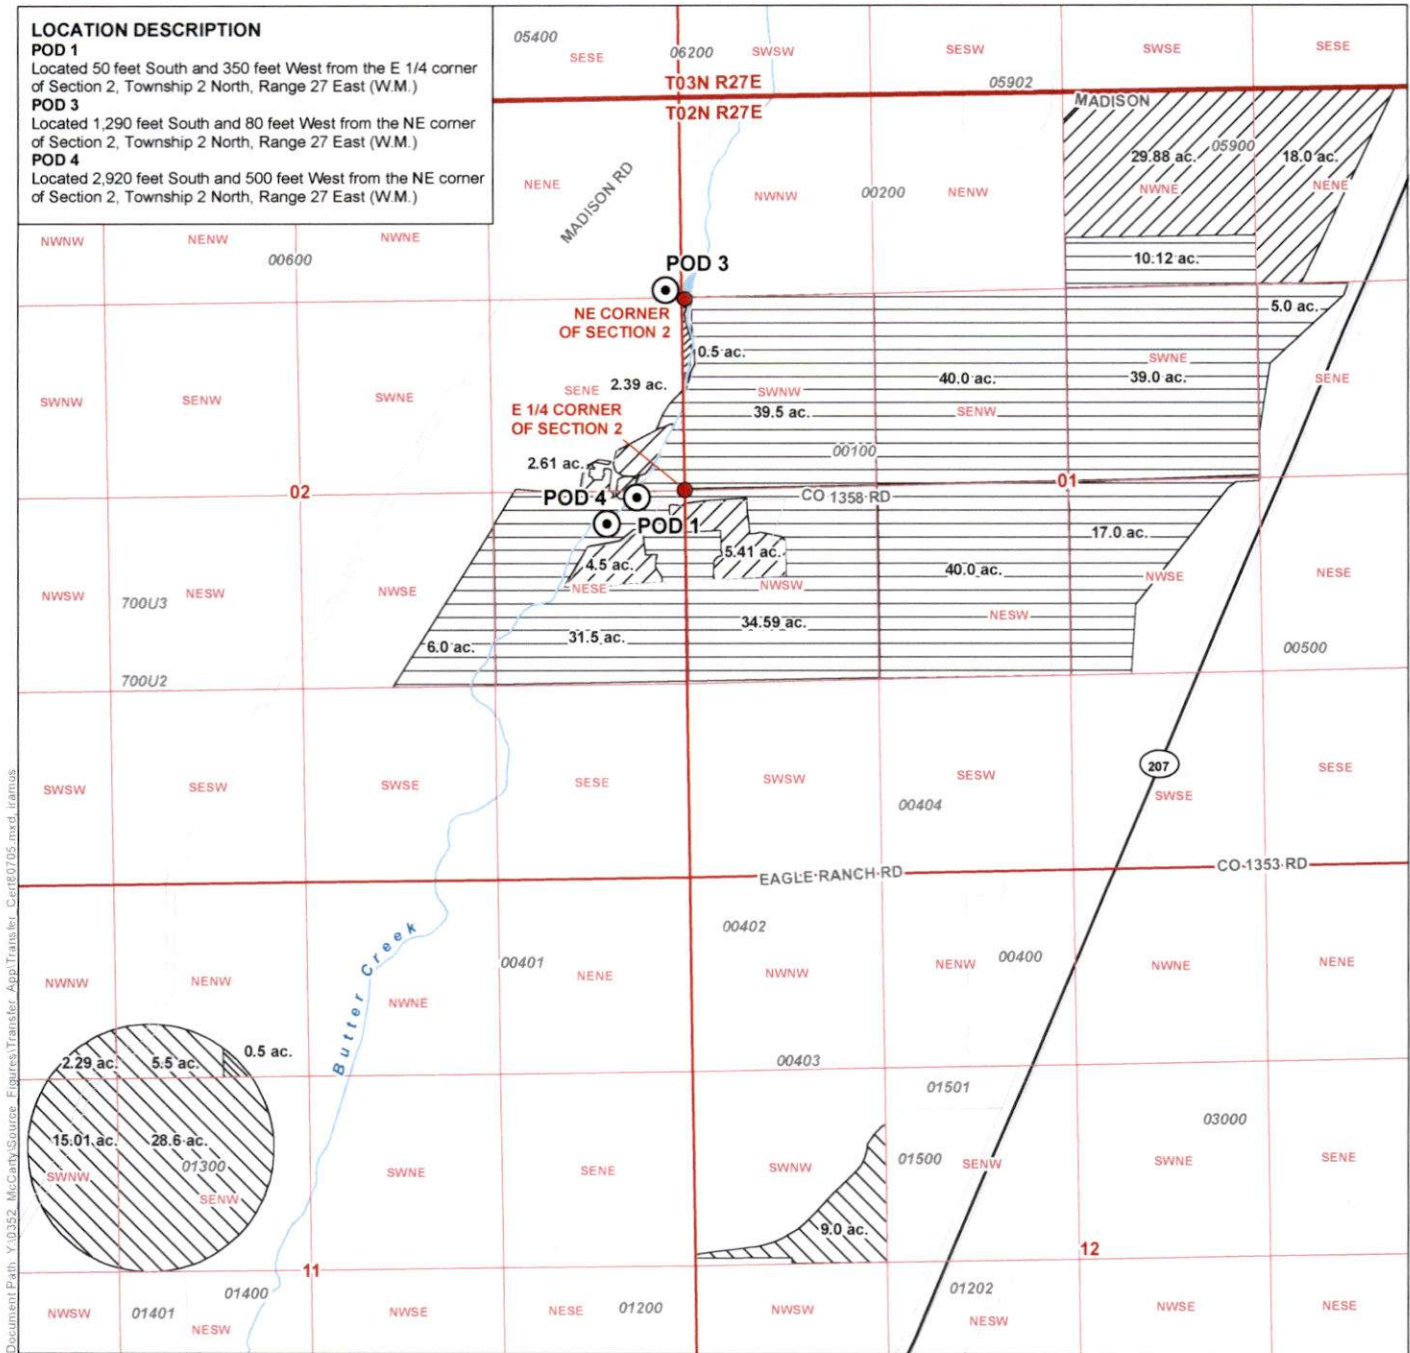


- LEGEND**
- Point of Diversion (POD)
  - Certificate 80705**
    - From Lands (12/31/1896), 60.4 ac.
    - From Lands (12/31/1884), 0.5 ac.
    - To Lands (12/31/1896), 60.4 ac.
    - To Lands (12/31/1884), 0.5 ac.
    - Remaining Lands, 265.1 ac.
  - All Other Features**
    - Tax Lot
    - Major Road
    - Watercourse

# **Application for a Water Right Transfer in the Name of McCarty Place of Use and Points of Appropriation, Primary Irrigation**

**Certificate 80705**  
 Township 2 North, Range 27 East (W.M.)


## **CERTIFIED WATER RIGHTS EXAMINER STAMP**

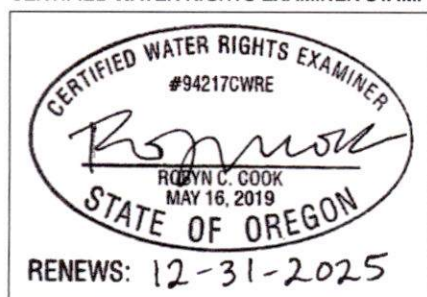

**Received**  
**JAN 10 2025**  
**OWRD**

**DISCLAIMER**  
 This map was prepared for the purpose of identifying the location of a water right only and it is not intended to provide legal dimensions or location of property ownership lines.

Date: August 30, 2024  
 Data Sources: BLM, ESRI, OWRD, USGS

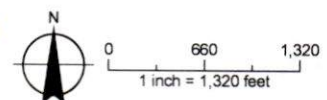

**Received**  
**DEC 20 2024**  
**OWRD**

T. 2 N., R. 27 E. WM.



SCALE IN FEET

== Architects & Engineers  
== Kennewick, WA 99336