


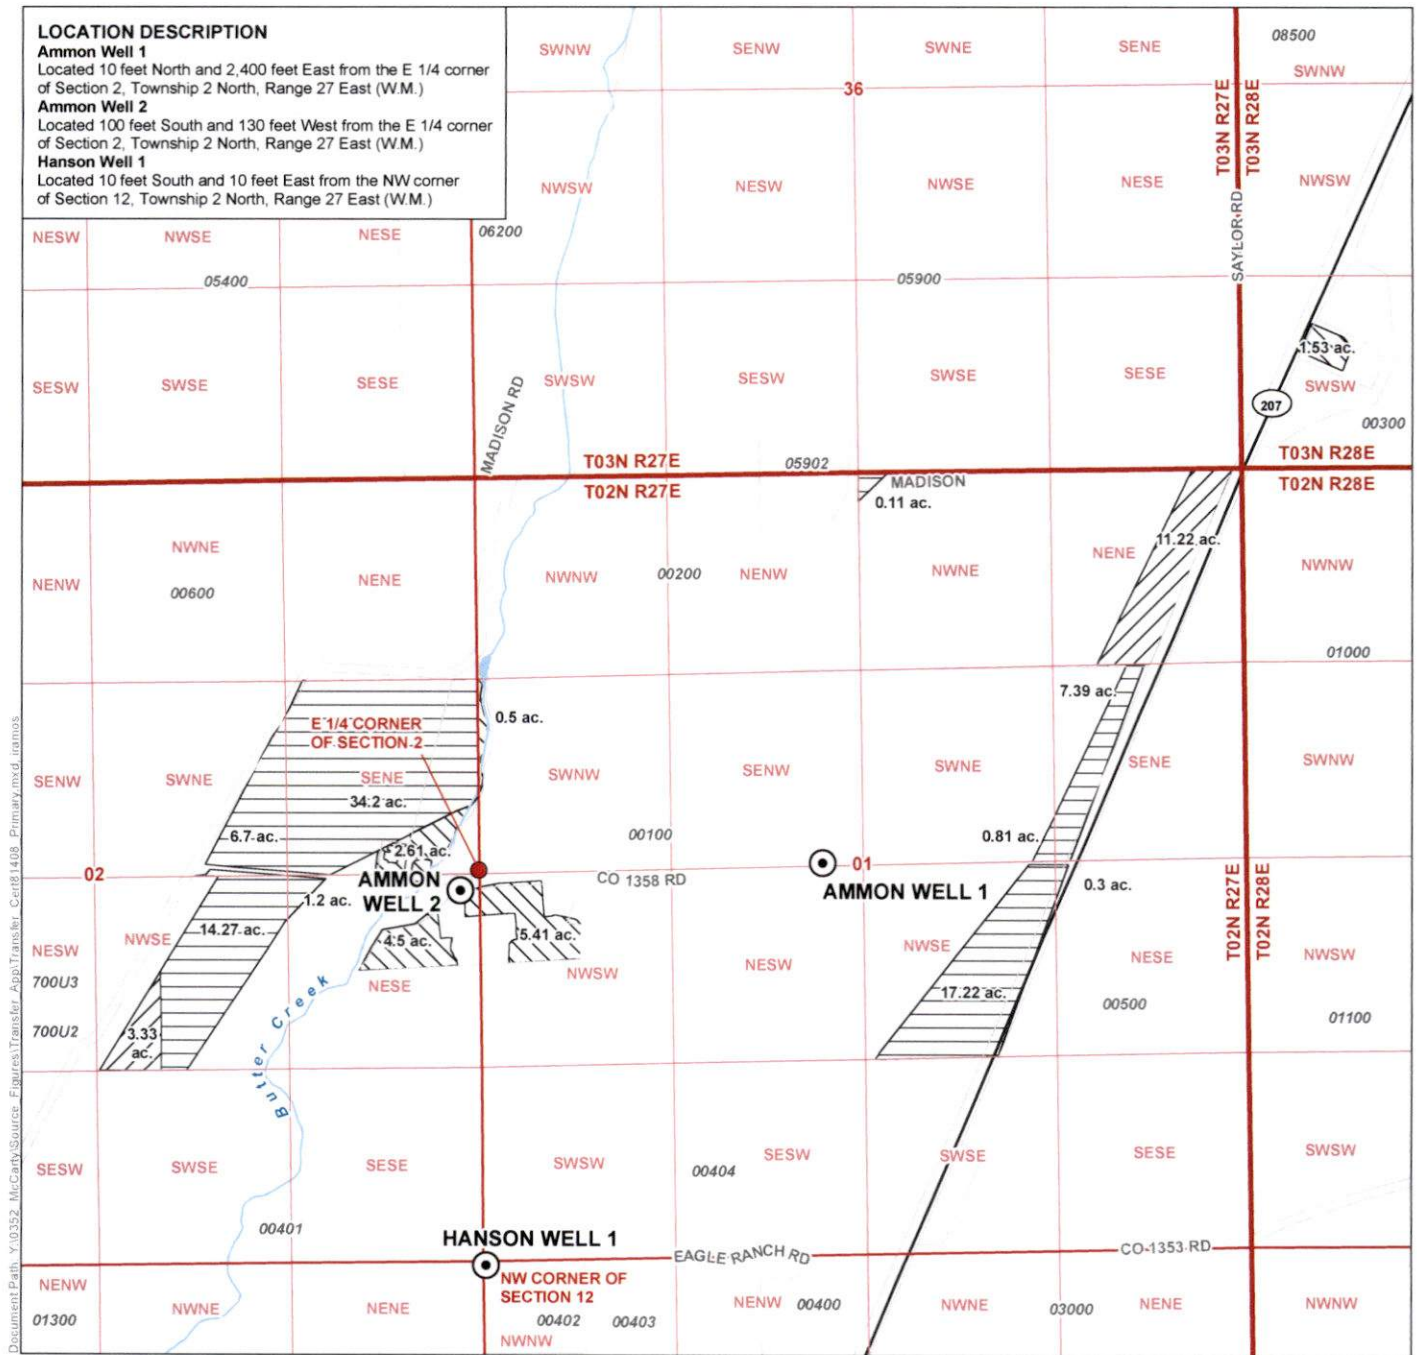


LEGEND
 ● Point of Appropriation (POA)
 Place of Use (POU)
 Certificate 81408, Primary
 ▨ From Lands, 14.55 ac.
 ▩ To Lands, 14.55 ac.
 □ Remaining Lands, 82.2 ac.

All Other Features

— Tax Lot
 — Major Road
 — Watercourse

Received
 DEC 24 2024
 OWRD

CERTIFIED WATER RIGHTS EXAMINER STAMP

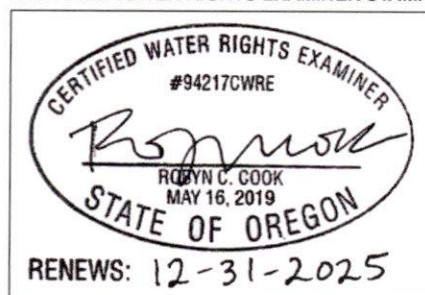

**Application for a Water Right Transfer
 in the Name of McCarty
 Place of Use and Points of Appropriation, Primary Irrigation**

Certificate 81408


Township 2/3 North, Range 27/28 East (W.M.)


Received
 JAN 10 2025
 OWRD

DISCLAIMER

This map was prepared for the purpose of identifying the location of a water right only and it is not intended to provide legal dimensions or location of property ownership lines.

Date: August 30, 2024
 Data Sources: BLM, ESRI, OWRD, USGS

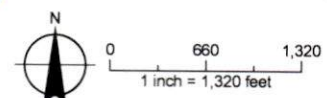

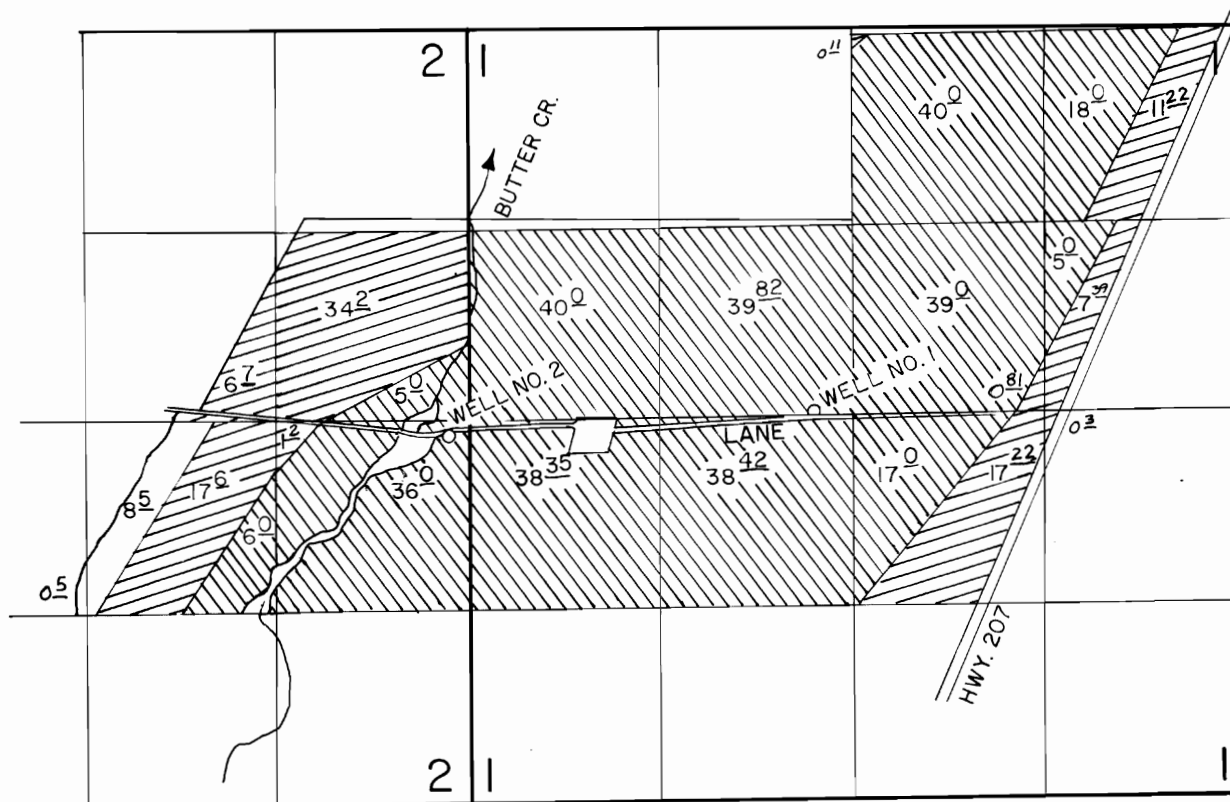

FINAL PROOF SURVEY

UNDER

PRIMARY

IN NAME OF

CLAUSIE H., SHELIA, EDWARD N., & ALICE AMMON

Surveyed JULY 21, 1960, by R. H. JACKSON.

Revised
5-12-86