


LAYOUT: COBU T-13939 11X17 PLOT: U:\Bent\Projects\Clients\8010-018 Cline Butte Eagle Crest Well 10\985000\DWG\COBU Map PLOTTED BY: OfferAny DATE: Thursday, November 20, 2025 1:25:34 PM

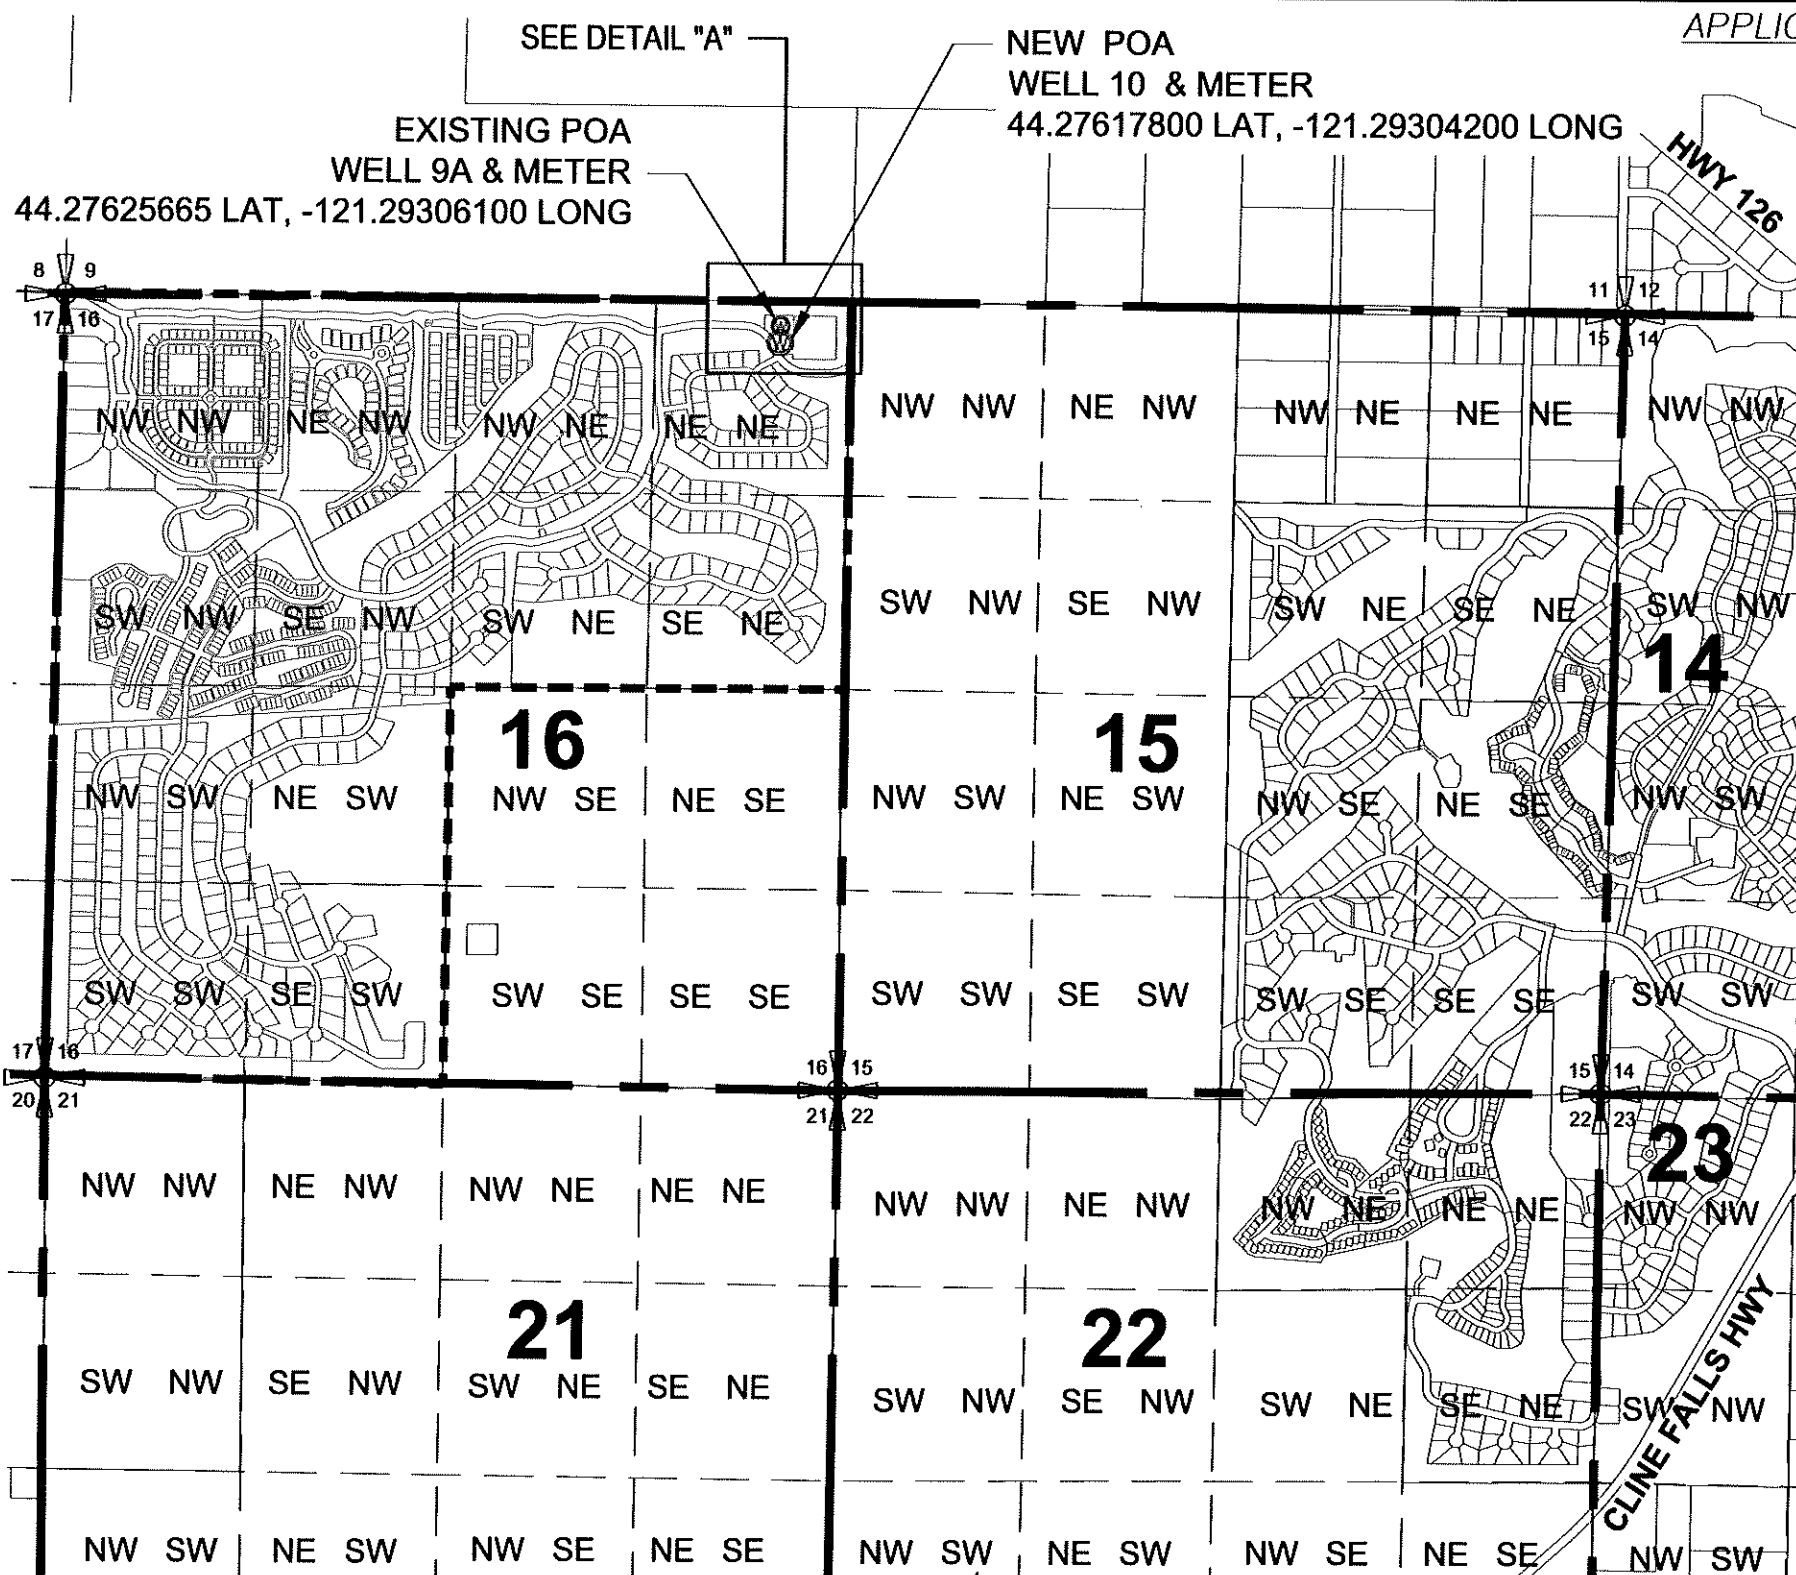



APPLICATION G-14857, PERMIT G-13856, TRANSFER T-13939
TOWNSHIP 15S, RANGE 12E, SECTION 16
TYPE OF USE:
QUASI-MUNICIPAL
PRIORITY DATE:
NOVEMBER 2, 1998

Received by OWRD
NOV 21 2025
Salem, OR


NOTE: THIS MAP WAS PREPARED FOR THE PURPOSE OF IDENTIFYING THE LOCATION OF WATER RIGHTS. THIS MAP IS NOT INTENDED TO PROVIDE LEGAL DIMENSIONS OR THE LOCATION OF PROPERTY OWNERSHIP LINES.

LEGEND

- WELL 9 POINT OF APPROPRIATION UNDER TRANSFER T-13939
- WELL 10 POINT OF APPROPRIATION ADDED BY TRANSFER T-13939
- AREA OF USE UNDER T-13939
- SECTION LINE
- TAXLOT LINE
- QUARTER SECTION LINE
- SECTION CORNER

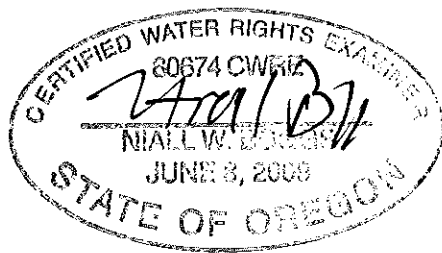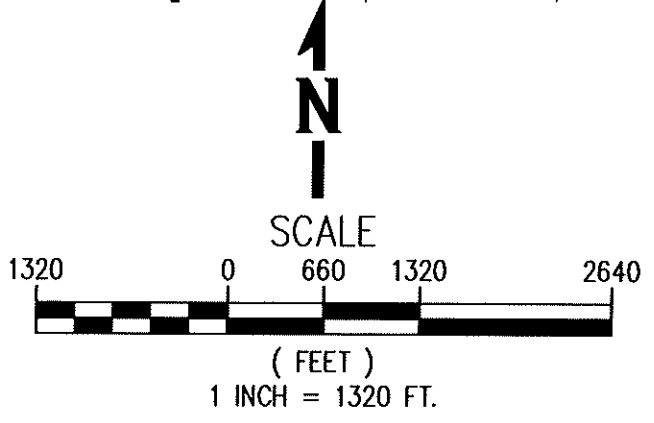

EXPIRES: 12-31-2027

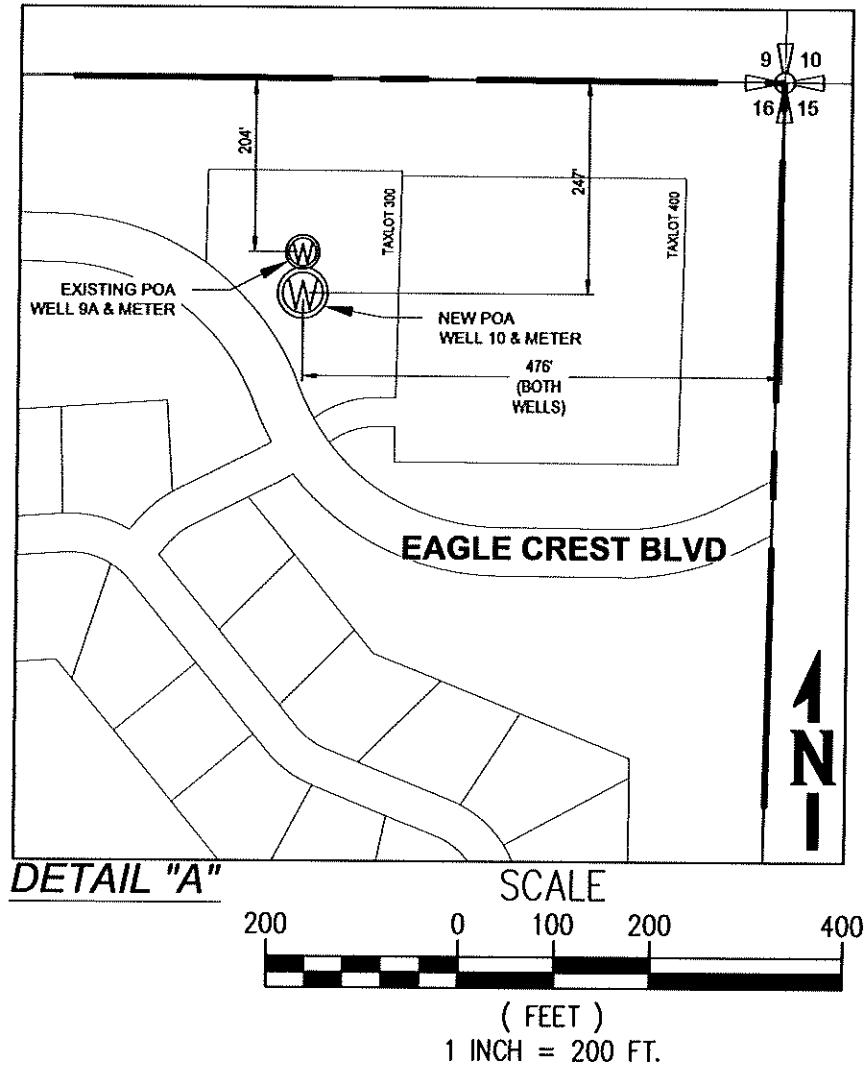

DATE				
BY				
REVISIONS				
ONE INCH AT FULL SCALE IS NOT SCALE ACCORDINGLY				
Parametrix				
PROJECT NAME: OREGON WATER UTILITIES, INC. TRANSFER T-13939				
DRAWING NO. 1 OF 1				
WR1.0				