


RECEIVED

JUL 30 1999

WATER RESOURCES DEPT.
SALEM, OREGON

T.1S. R.3E., W.M

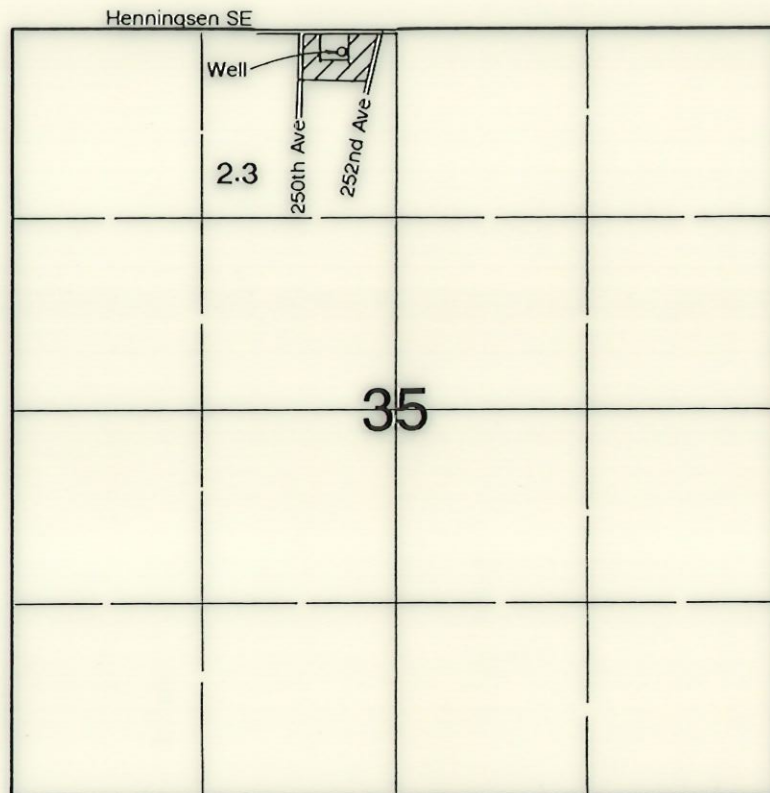

1" = 1320'



Area Irrigated

Well is located 160'S & 400' W from the N-1/4 corner of Section 35.

Final Proof Survey

Application #: G-13471 Permit #: G-12030

In Name Of

Keith & Deborah Flewelling

Surveyed on July 22, 1999 by JM Schuette

This Map Was Prepared For The Purpose Of Identifying The Location Of A Water Right Only And Is Not Intended To Provide Legal Dimensions Or Location Of Property Ownership Lines.

