



Document Path: \\VMS\GIS_Files\2338_Ponderosa_Pines\Source_Figures\COBU_Permit_G18309.aprx COBU_Permit_18309.bramos

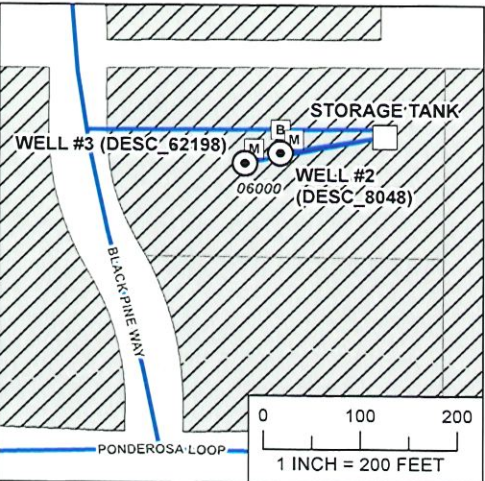

- LEGEND**
- POA
 - Meter
 - Booster Pumps
 - Storage Tank
 - Conveyance
 - Place of Use (POU) (286 Lots)
 - Tax Lot
 - Government Lot (GL)
 - Watercourse

CERTIFIED WATER RIGHTS EXAMINER STAMP

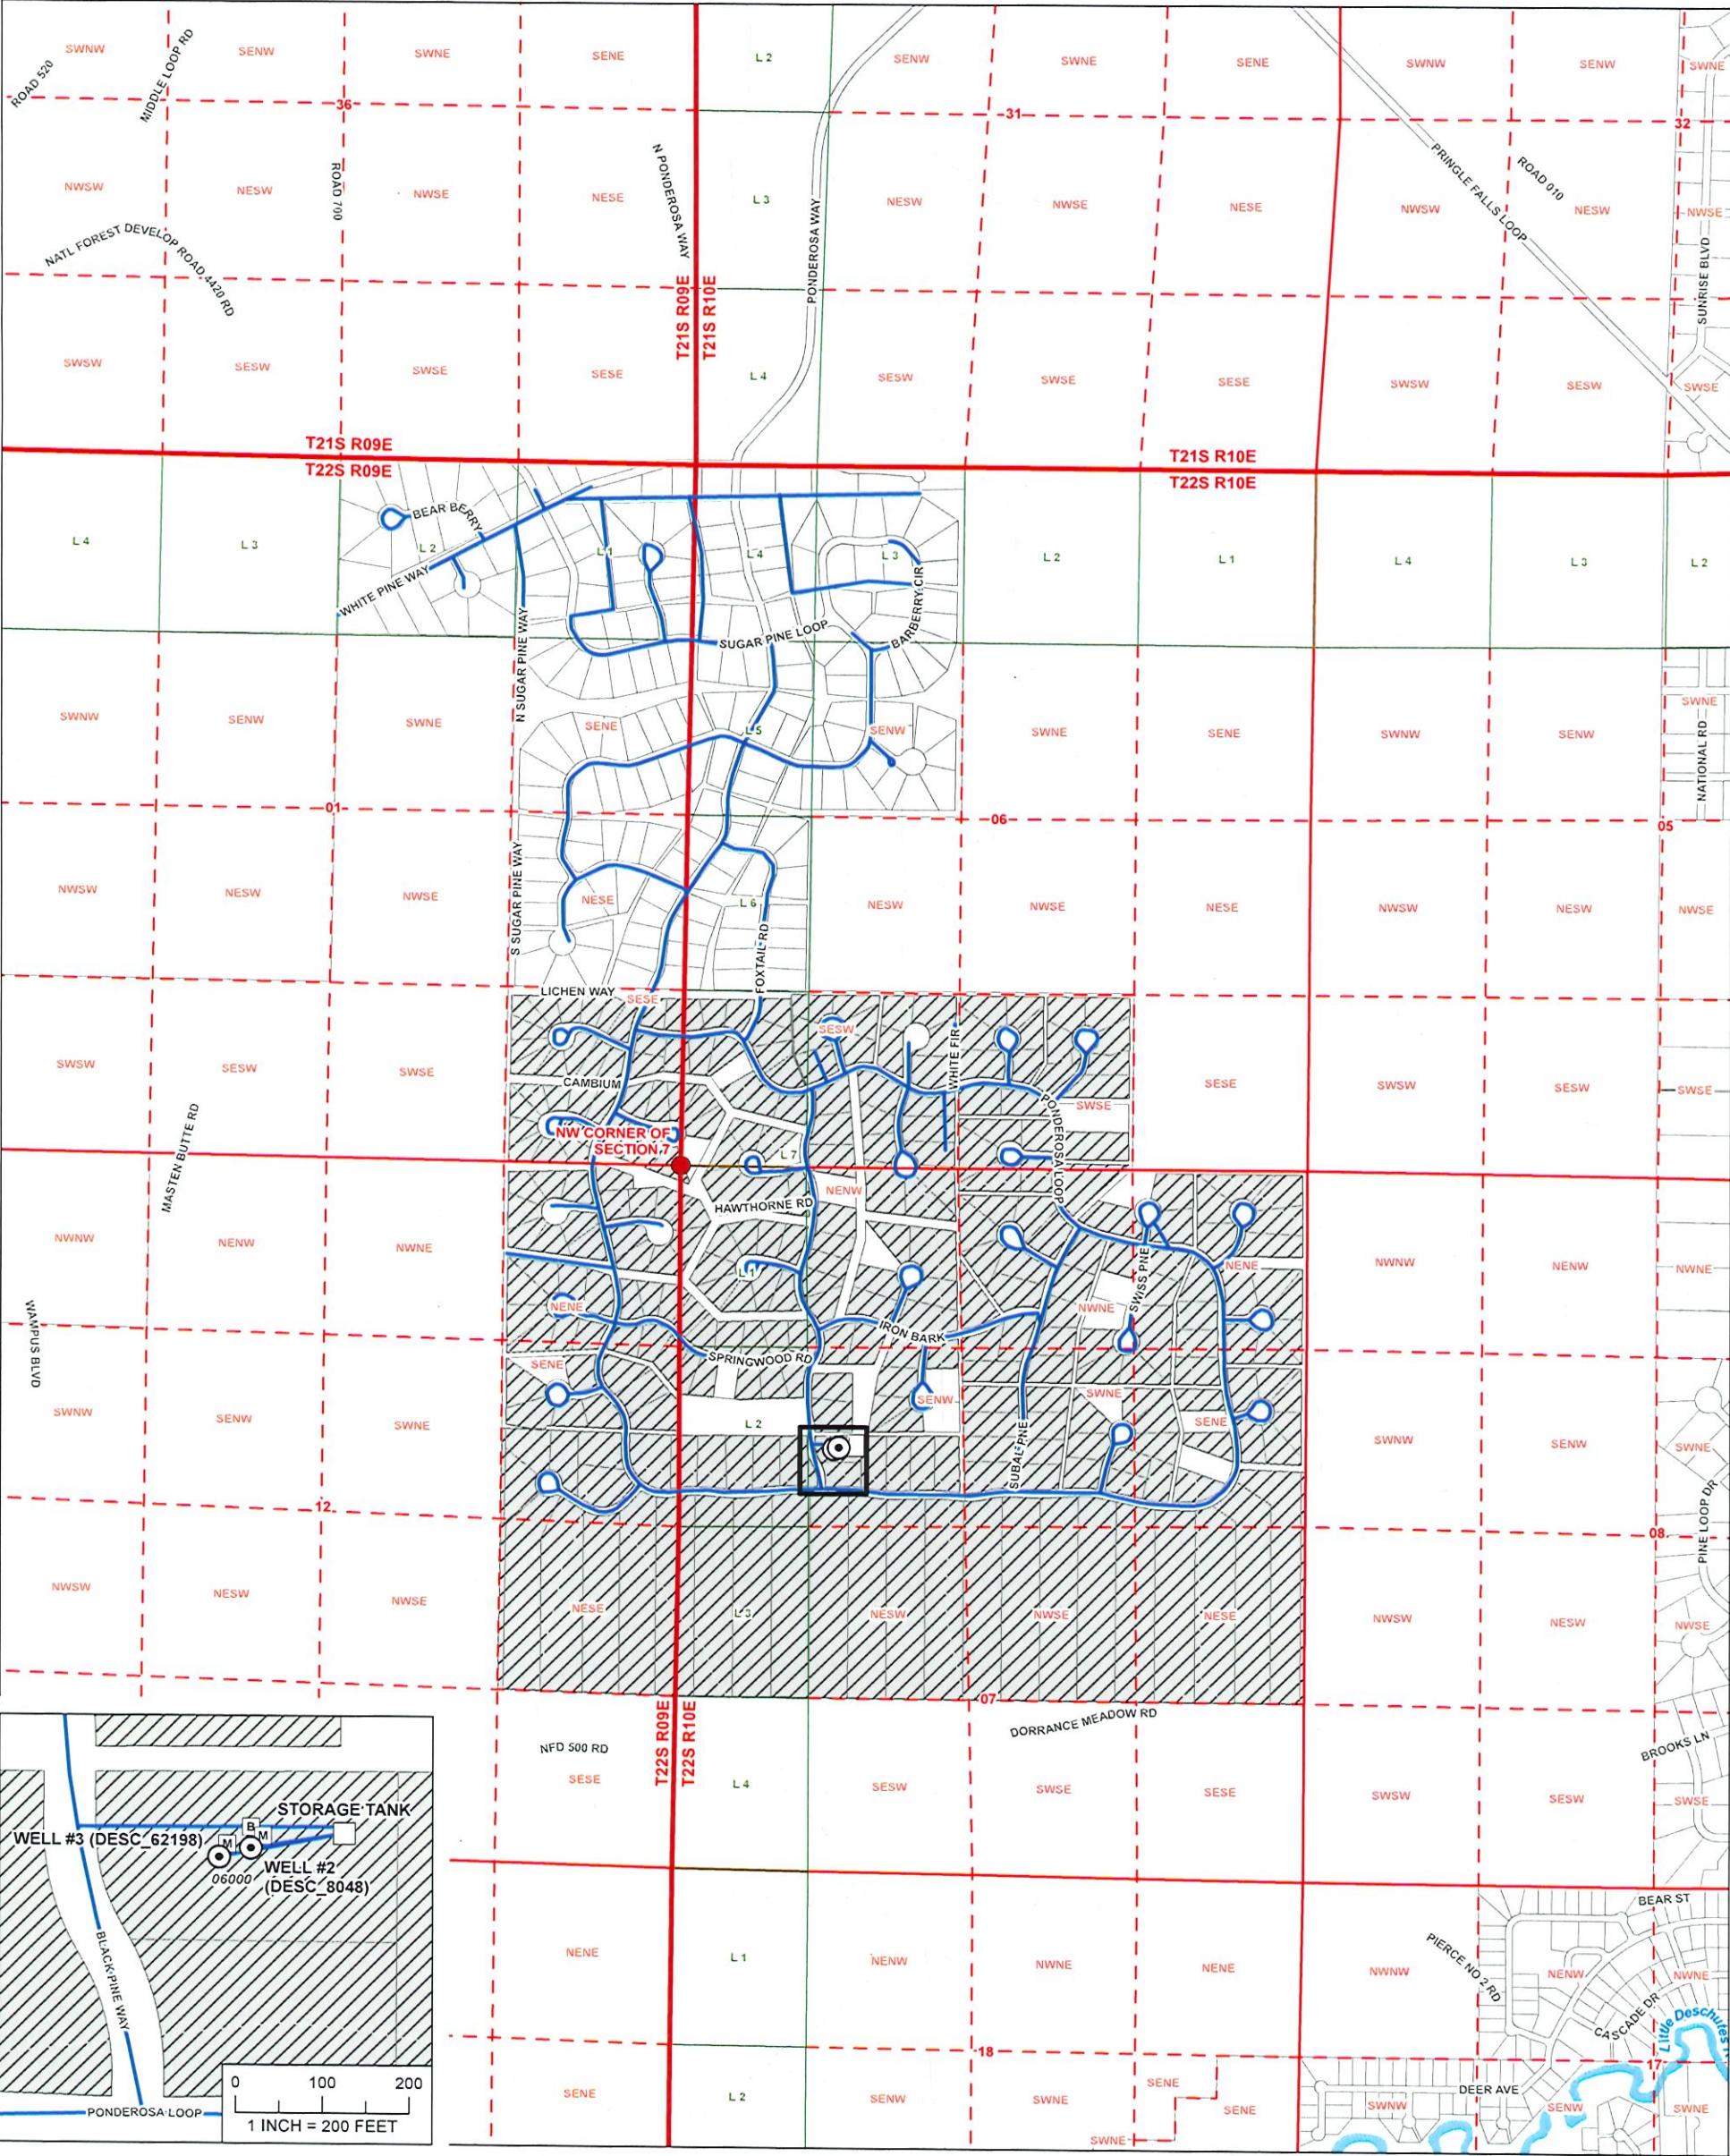

LOCATION DESCRIPTION
Well #2 (DESC_8048)
Located 2,106 feet South and 1,191 feet East from the NW corner of Section 7, Township 22 South, Range 10 East (W.M.)
Meter Location: Approximately 5 feet from well in the well house.
Well #3 (DESC_62198)
Located 2,108 feet South and 1,161 feet East from the NW corner of Section 7, Township 22 South, Range 10 East (W.M.)
Meter Location: Approximately 5 feet from well in the well house.

Claim of Beneficial Use Map
Ponderosa Pines Water Company
Application G-9118
Permit G-18309
Township 22 South, Ranges 9 and 10 East (W.M.)

Received
MAR 10 2026
OWRD

DISCLAIMER
This map was prepared for the purpose of identifying the location of a water right only and it is not intended to provide legal dimensions or location of property ownership lines.
Date: February 16, 2026
Data Sources: BLM, ESRI, OWRD, USGS

