



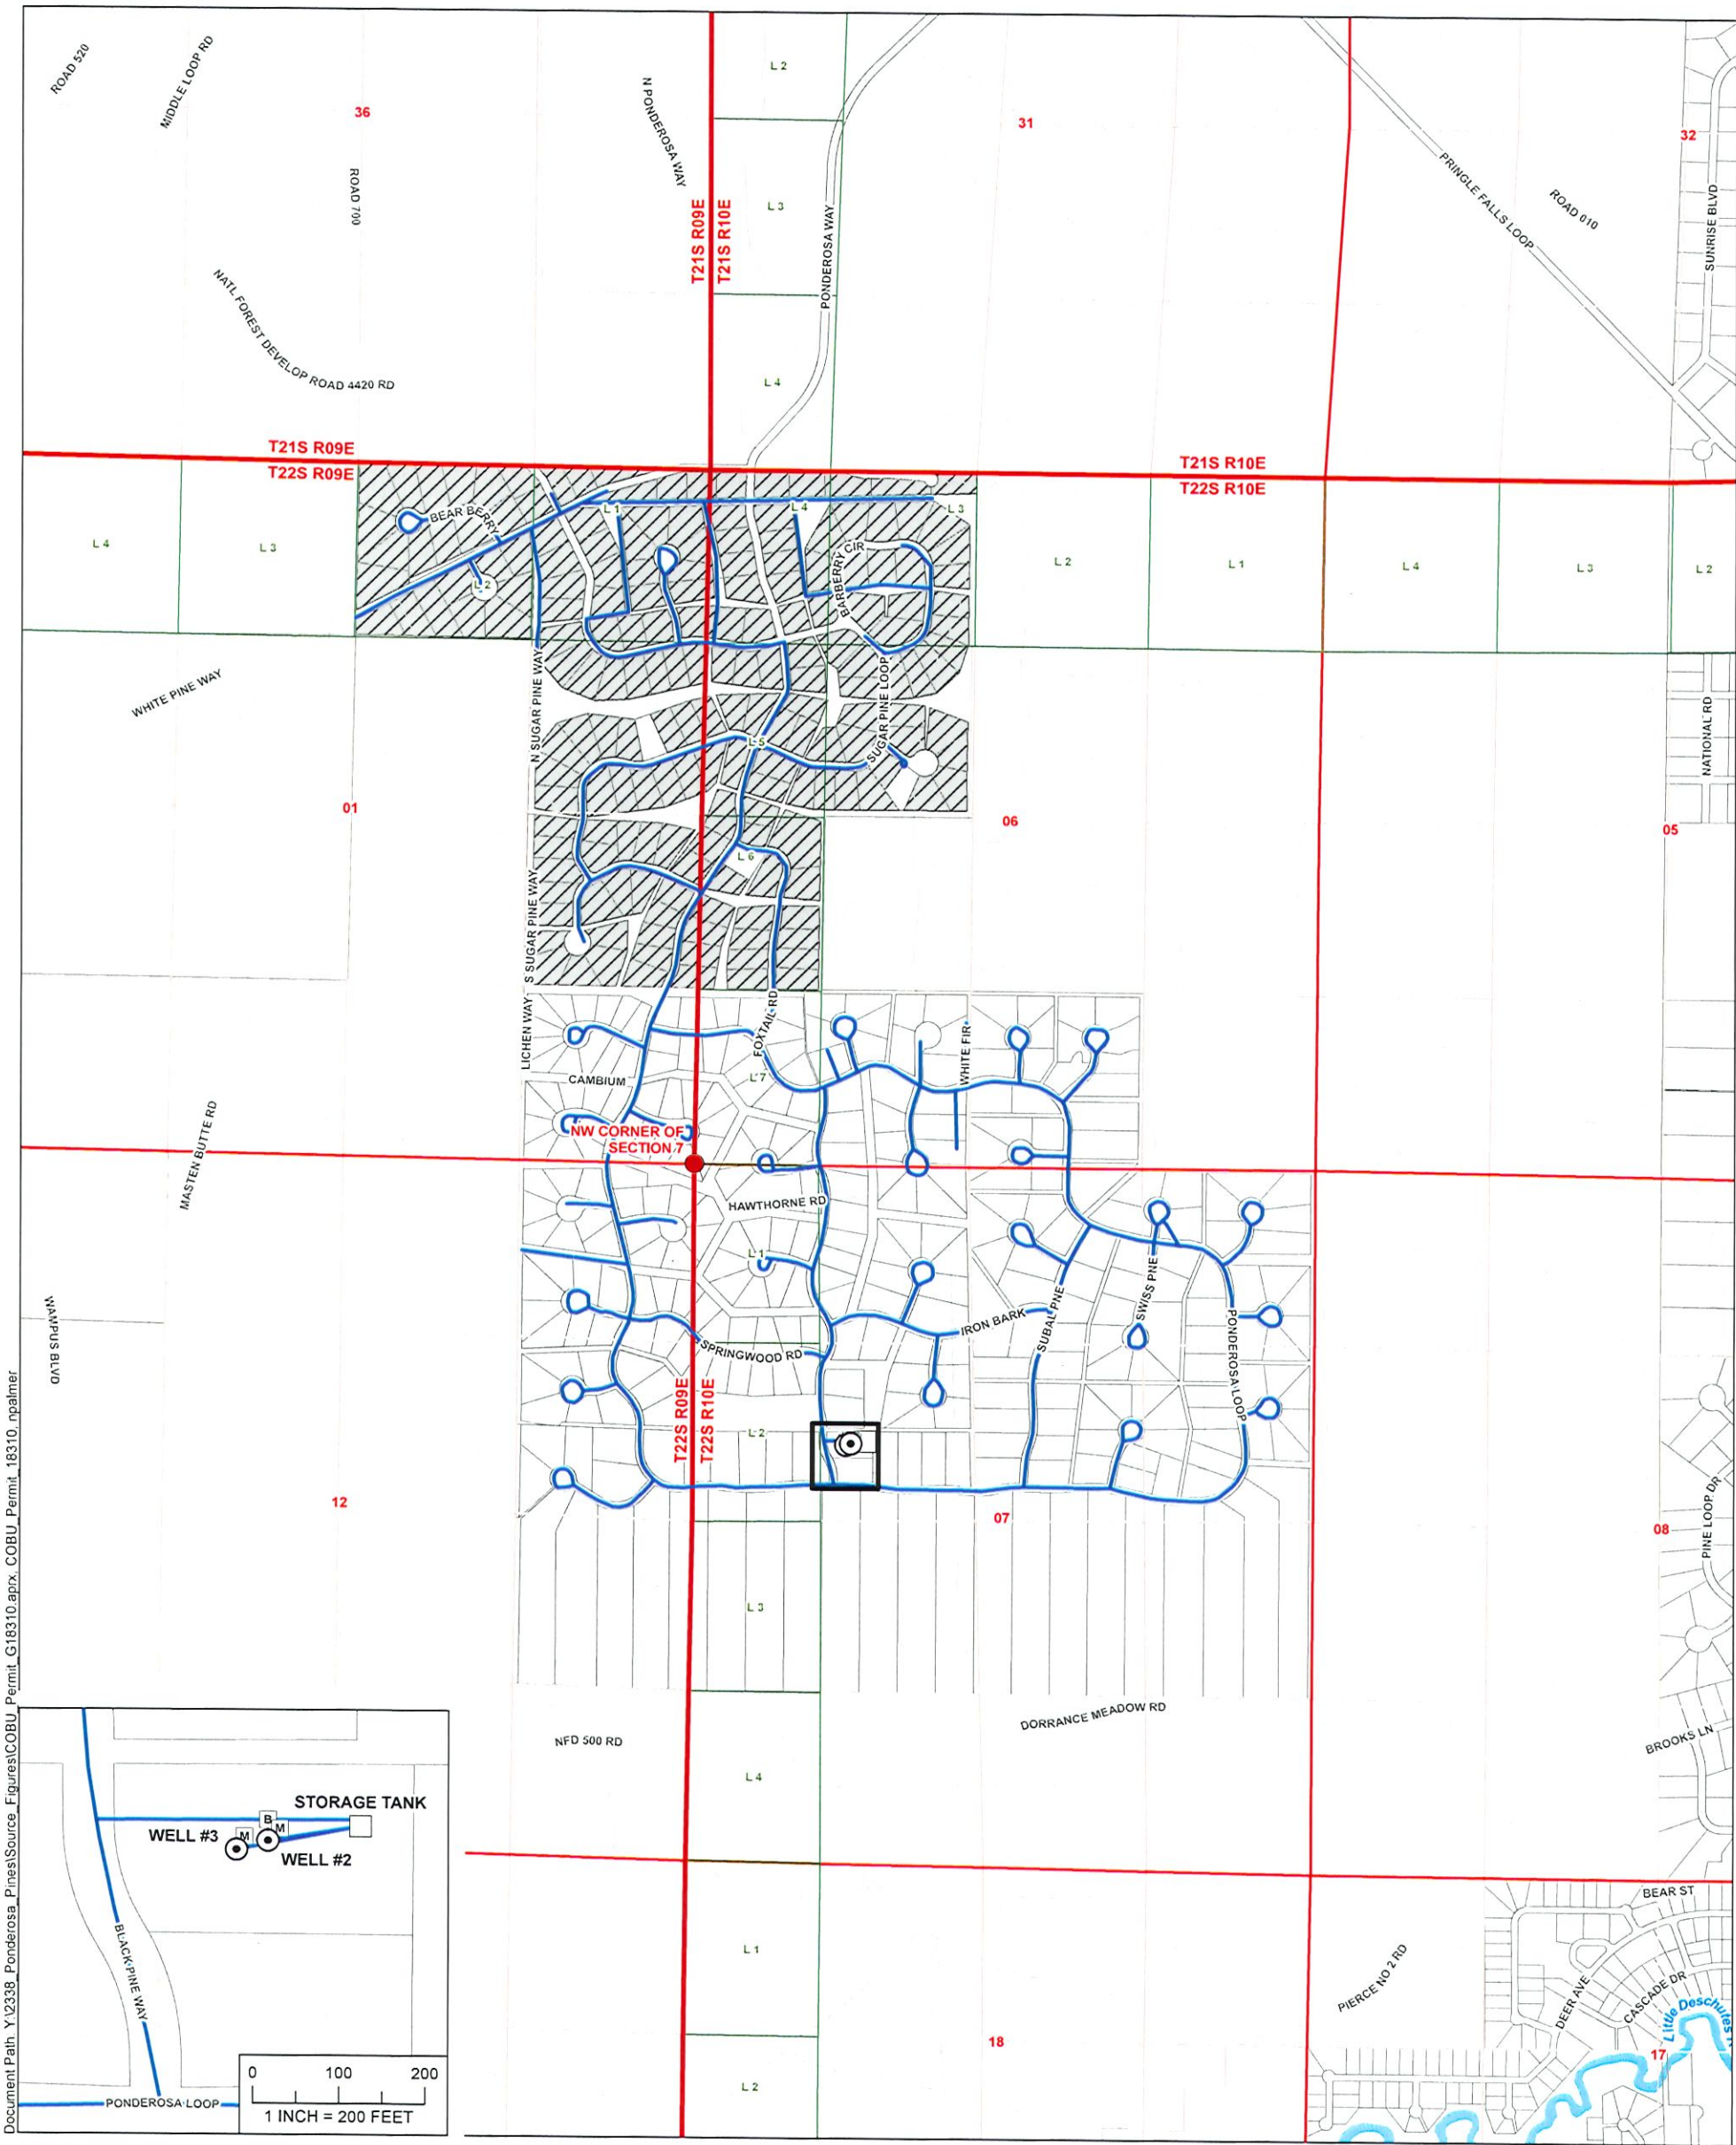

- LEGEND**
- | | |
|----------------|-----------------------|
| ⊙ POA | ▨ Place of Use (POU) |
| Ⓜ Meter | □ Tax Lot |
| Ⓟ Booster Pump | ▭ Government Lot (GL) |
| □ Storage Tank | ~ Watercourse |
| — Conveyance | 💧 Waterbody |

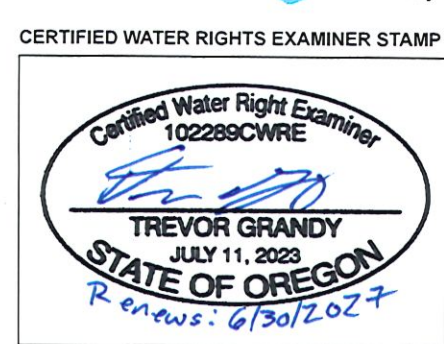

LOCATION DESCRIPTION
Well #2
Located 2,106 feet South and 1,191 feet East from the NW corner of Section 7, Township 22 South, Range 10 East (W.M.)
Well #3
Located 2,108 feet South and 1,161 feet East from the NW corner of Section 7, Township 22 South, Range 10 East (W.M.)

Claim of Beneficial Use Map
Ponderosa Pines Water Company
Application G-7020
Permit G-18310
Township 22 South, Ranges 9 and 10 East (W.M.)

Received
MAR 10 2026
OWRD

DISCLAIMER
This map was prepared for the purpose of identifying the location of a water right only and it is not intended to provide legal dimensions or location of property ownership lines.
Date: January 6, 2026
Data Sources: BLM, ESRI, OWRD, USGS

