



T25S R32E, WM
HARNEY COUNTY, OREGON


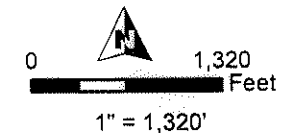


- POU IR**
- 1886
 - 1887
 - Section
 - Quarter Quarter
 - Tax Lot
 - Stream
 - Ditch
 - POD
 - Dam with weirs

POD LOCATIONS
 Dam with weirs: 1,760' N, 430' E of SW COR Sec 10
 POD 1: 1,860' N, 390' E of SW COR Sec 10
 POD 2: 1,800' N, 340' E of SW COR Sec 10

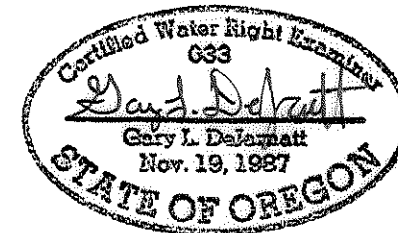

RENEWAL DATE 12/31/2019

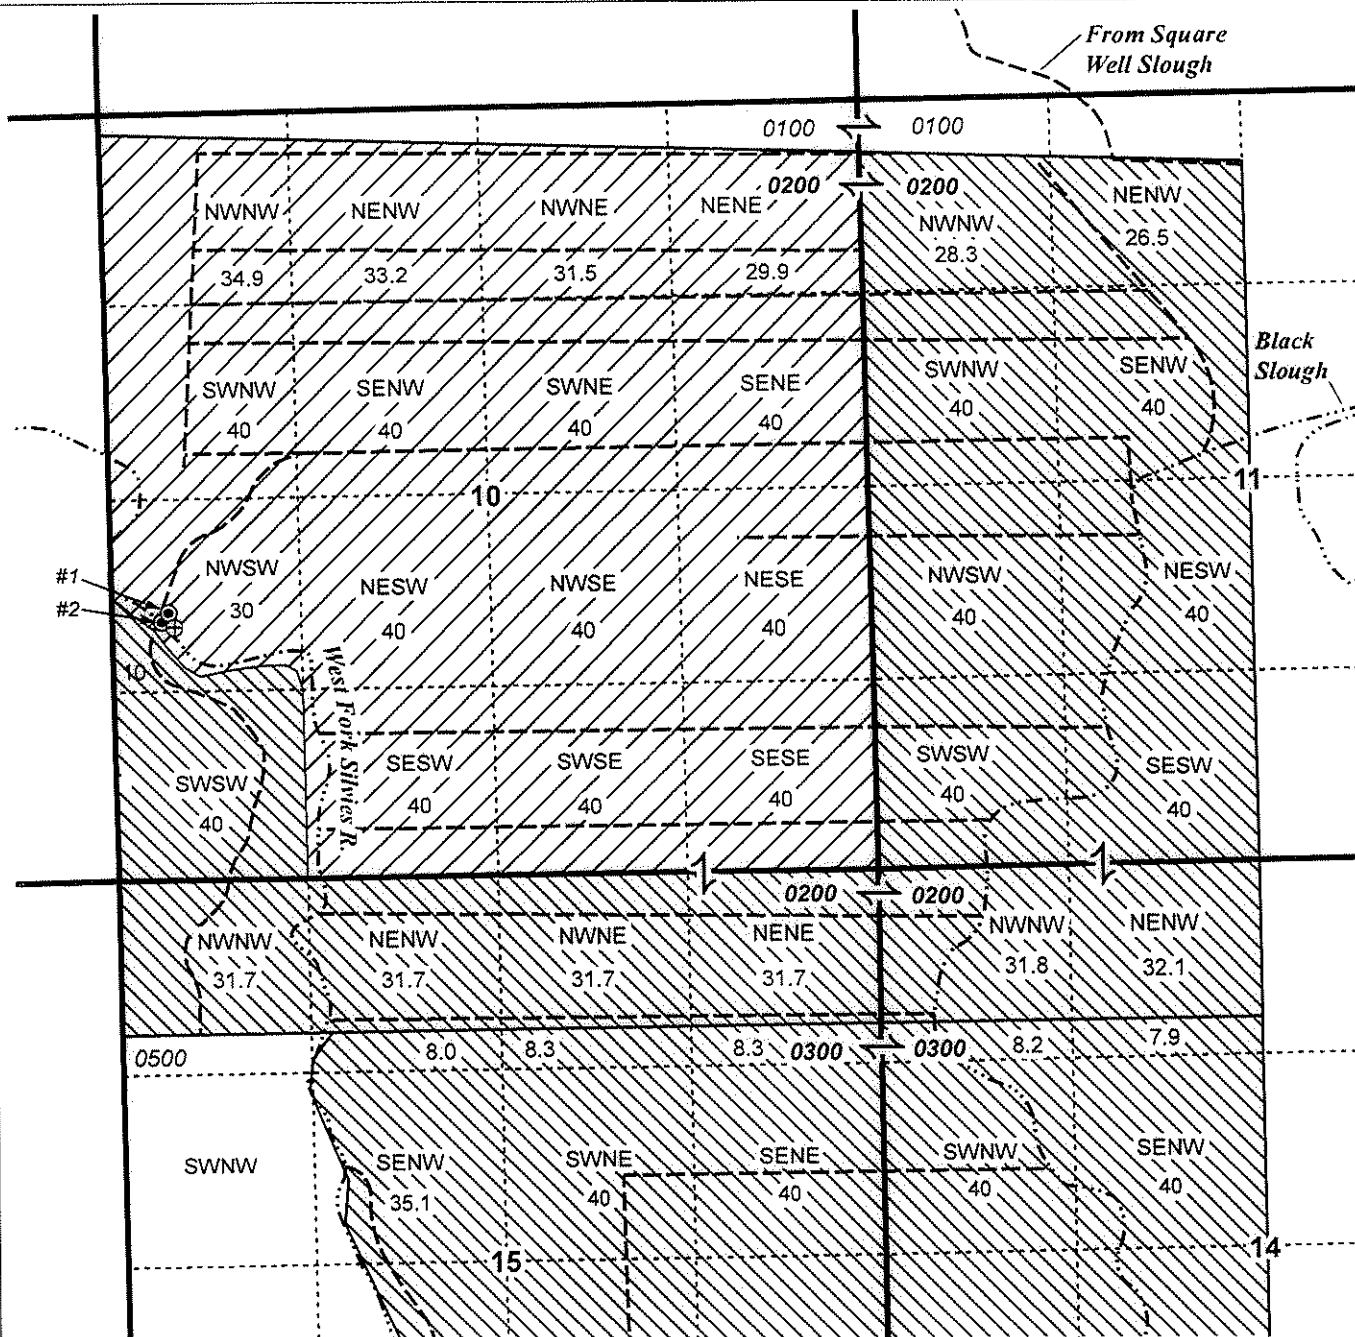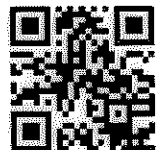

CLAIM OF BENEFICIAL USE MAP
Trainer Juhl Ranch

NOTE: THIS MAP IS NOT INTENDED TO
 PROVIDE LEGAL DIMENSIONS OR LOCATIONS
 OF PROPERTY OWNERSHIP LINES.

WATER RIGHT SERVICES, LLC
 PO BOX 1830, BEND, OR 97709
 CCB# 197121 www.oregonwater.us
 541-389-2837 JOHNSHORT@USA.COM


T-12707

MAP 1 OF 2

PROJECT #19009

APRIL 29, 2019

T25S R32E, WM
HARNEY COUNTY, OREGON

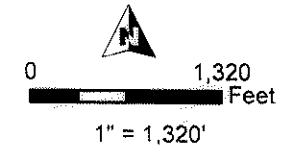


POU IR



- 1887
- Section
- Quarter Quarter
- Tax Lot
- Stream
- Ditch

POD LOCATIONS

Dam with weirs: 1,760' N, 430' E of SW COR Sec 10
 POD 1: 1,860' N, 390' E of SW COR Sec 10
 POD 2: 1,800' N, 340' E of SW COR Sec 10

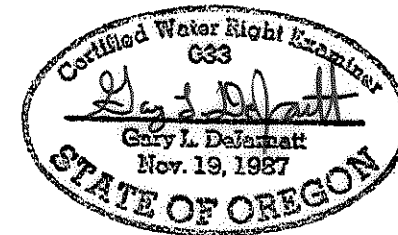

RENEWAL DATE 12/31/2019

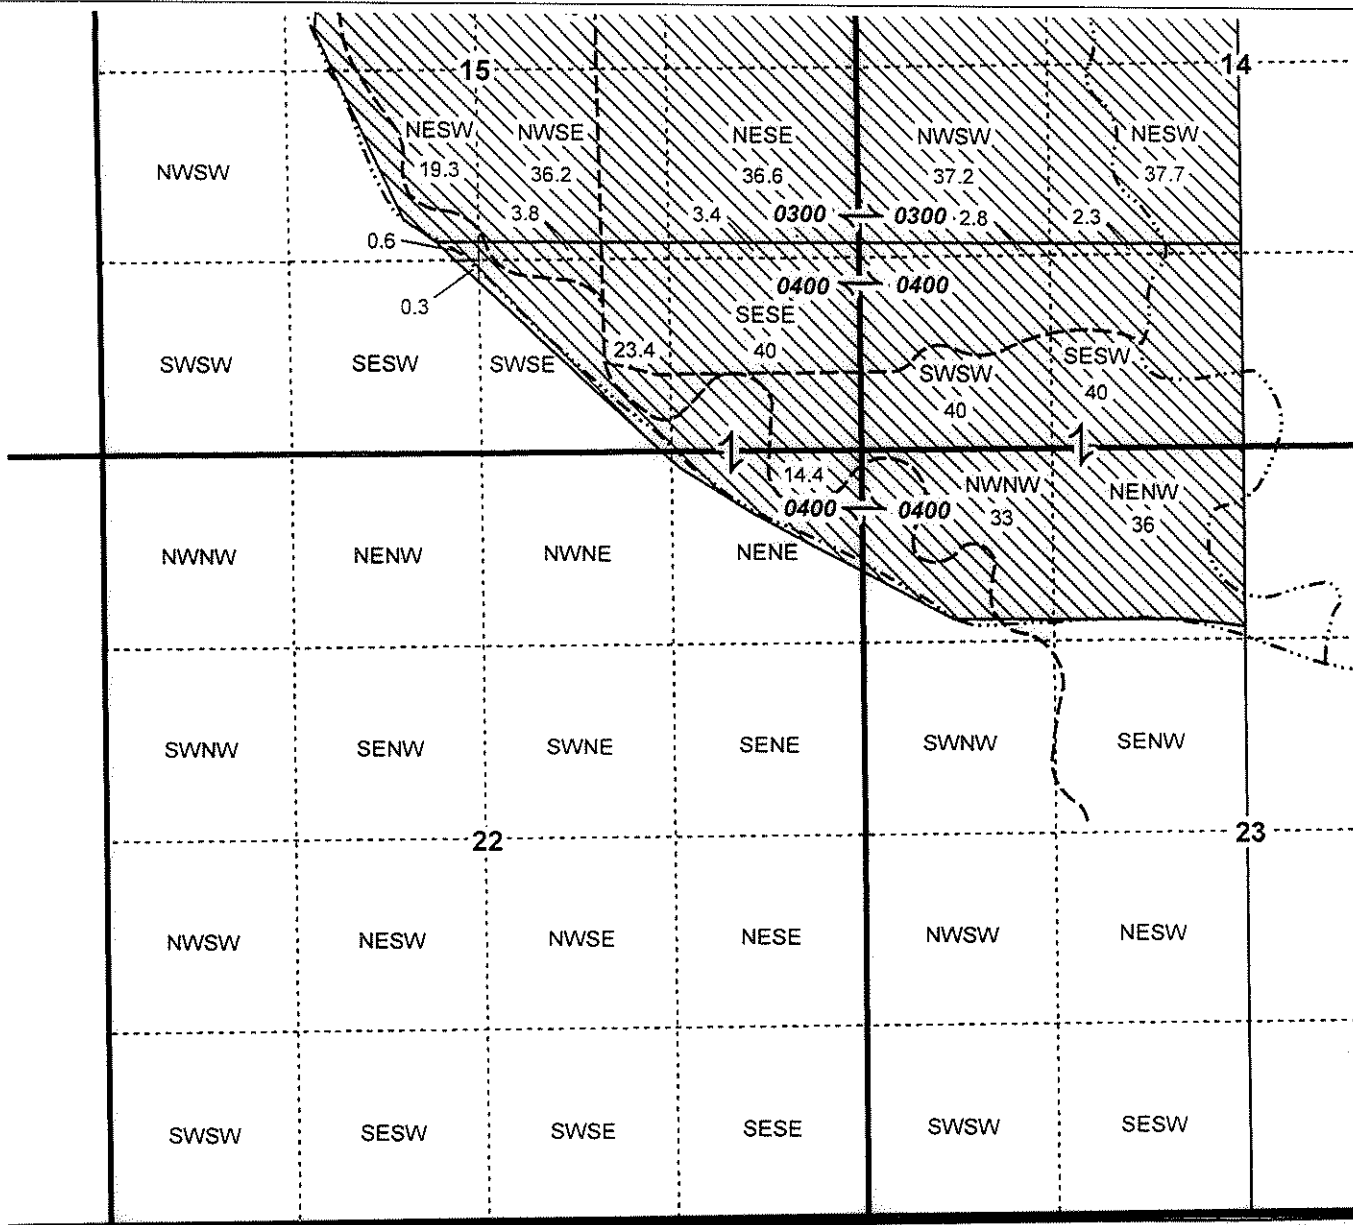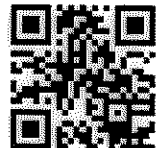

CLAIM OF BENEFICIAL USE MAP
Trainer Juhl Ranch

NOTE: THIS MAP IS NOT INTENDED TO
 PROVIDE LEGAL DIMENSIONS OR LOCATIONS
 OF PROPERTY OWNERSHIP LINES.

WATER RIGHT SERVICES, LLC
 PO BOX 1830, BEND, OR 97709
 CCB# 197121 www.oregonwater.us
 541-389-2837 JOHNSHORT@USA.COM

T-12707

MAP 2 OF 2

PROJECT #19009

APRIL 29, 2019