


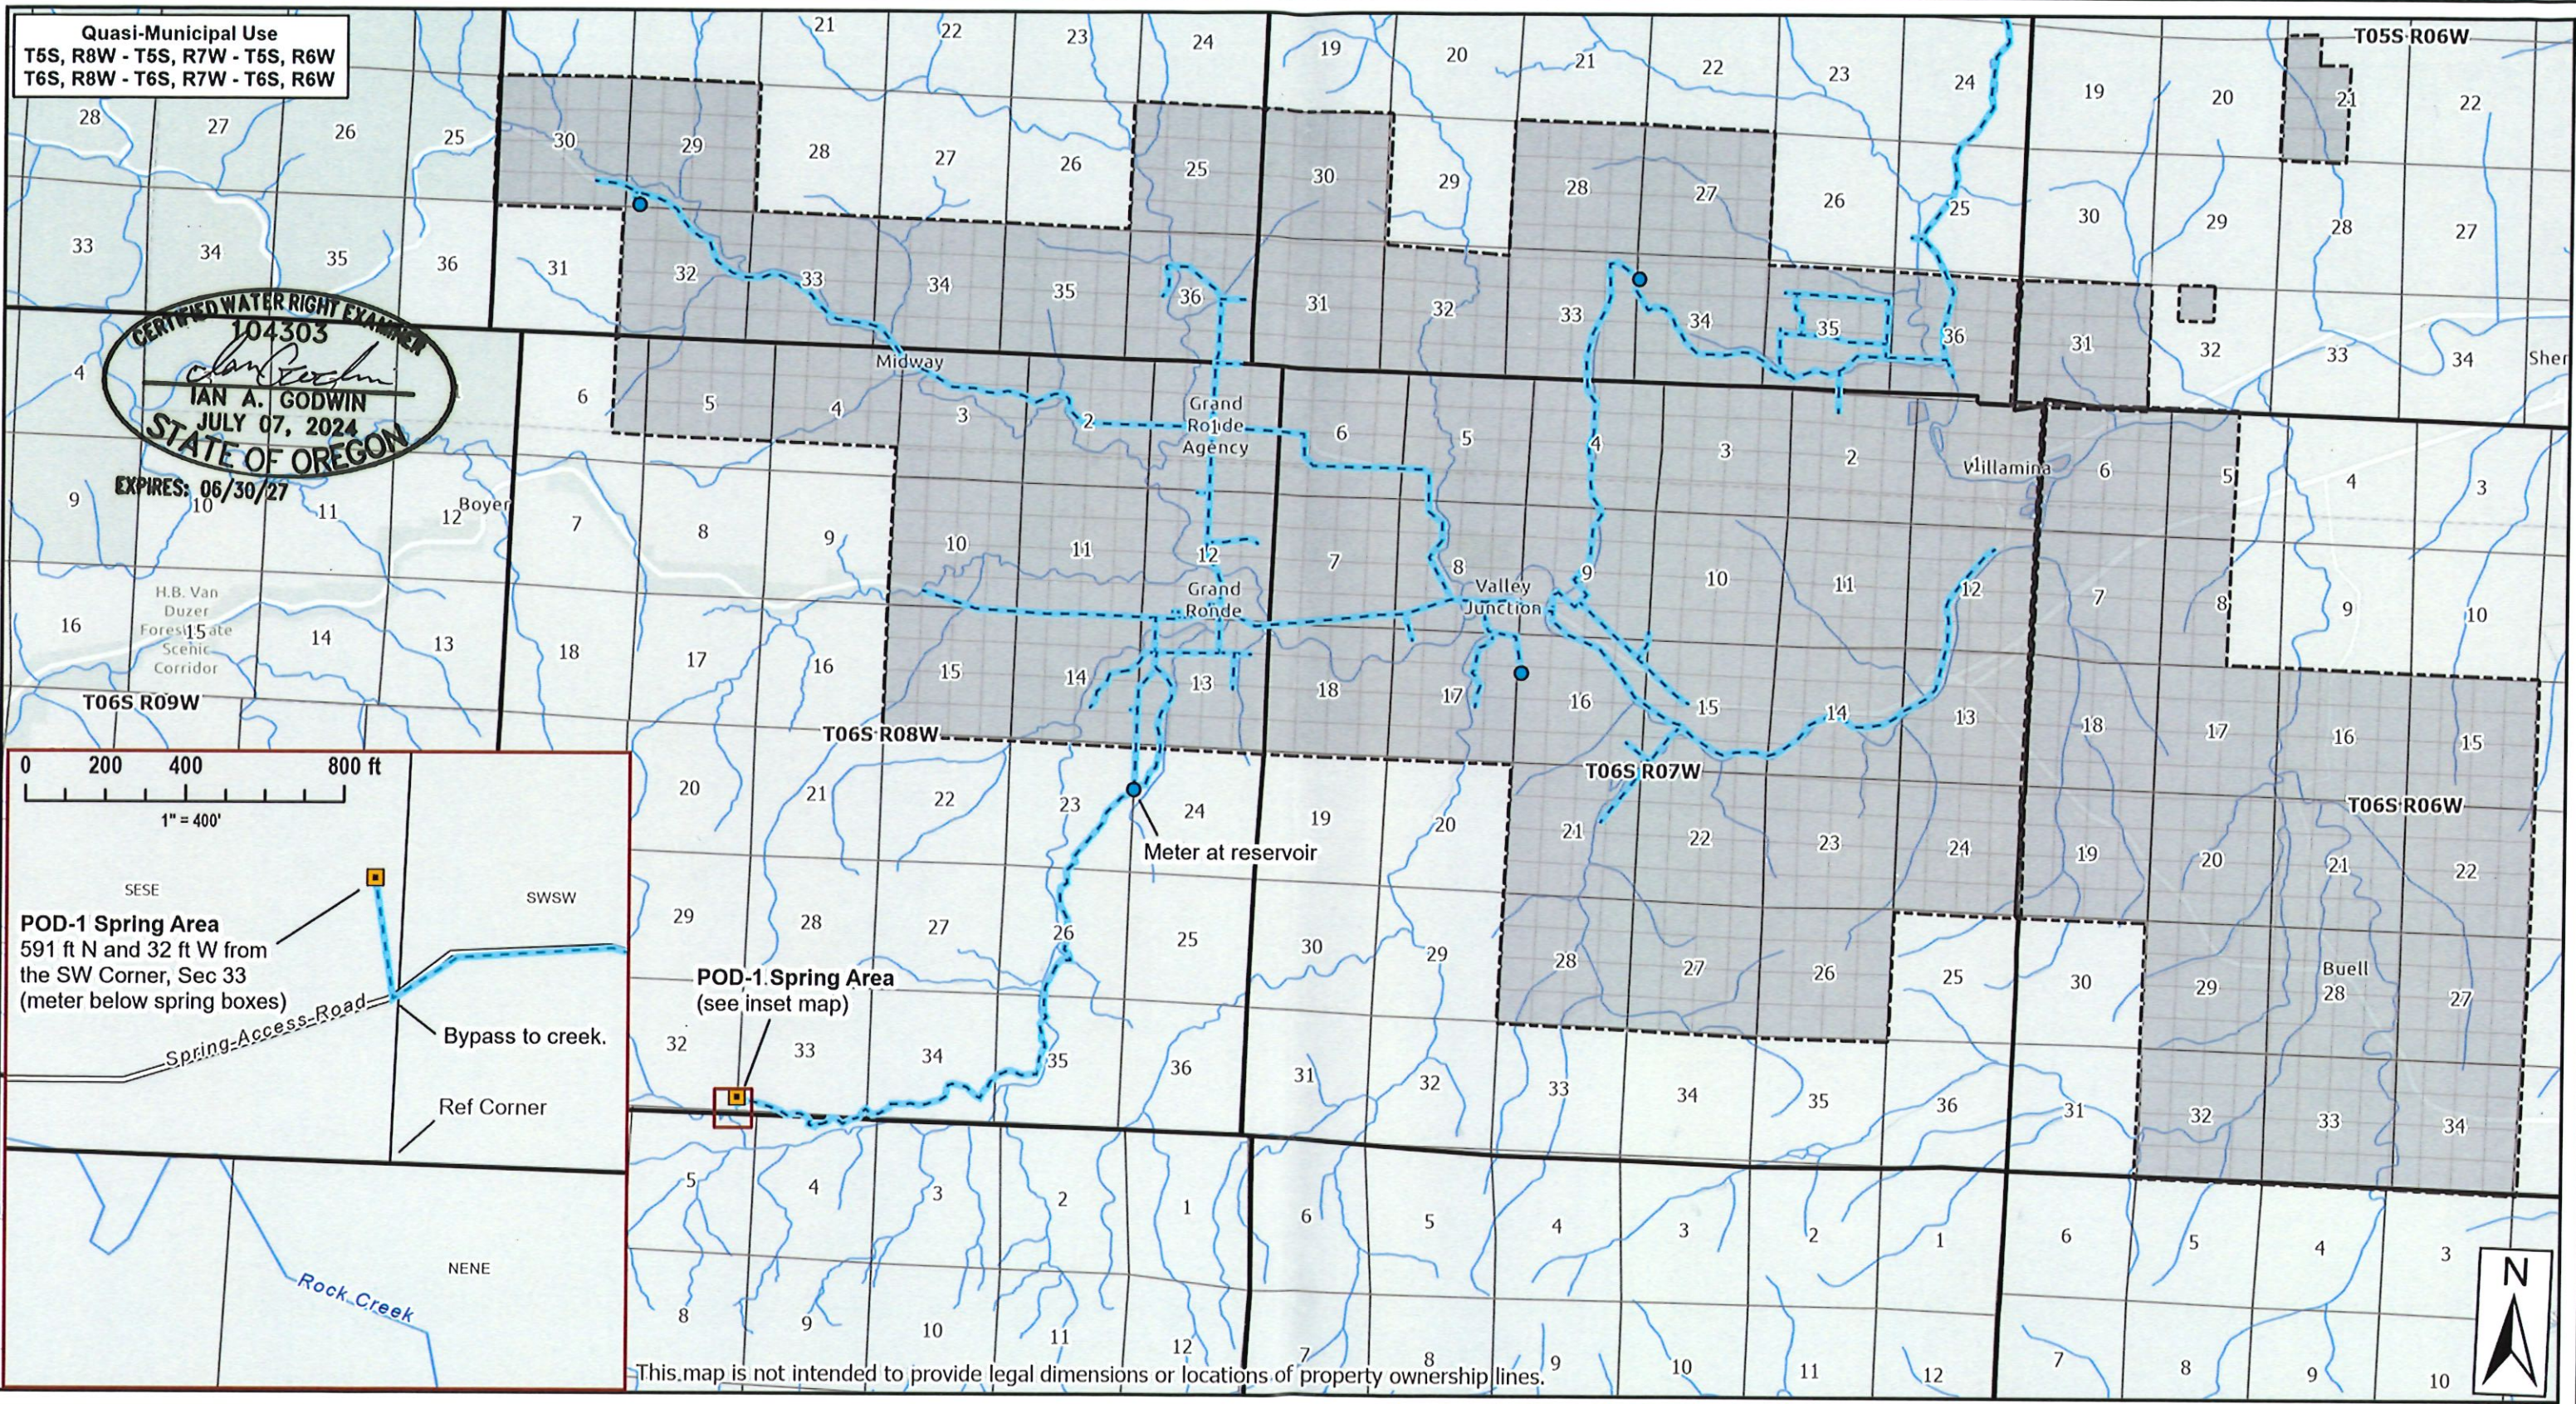



Complete Water Management

311 B Avenue, Suite P
Lake Oswego, OR 97034
(503) 954-1326

ATTACHMENT 1 - Claim Map
Grand Ronde Community Water Association
App. S-52770, Permit S-41437

1	DATE	AUTHOR	DRAFT

0 1 2 4 Miles

1 : 79,200 or 1" = 6,600'

Proj#: 2530001
Grand Ronde CWA
Grand Ronde Community Water Association
26690 Salmon River Hwy
Grand Ronde, OR 97347

Permit S-41437 POU

S-41437 POD

Approx. Distribution

Reservoir

Received
JAN 12 2026
OWRD