




Jefferson County
Township 13 South, Range 14 East from the Willamette Meridian

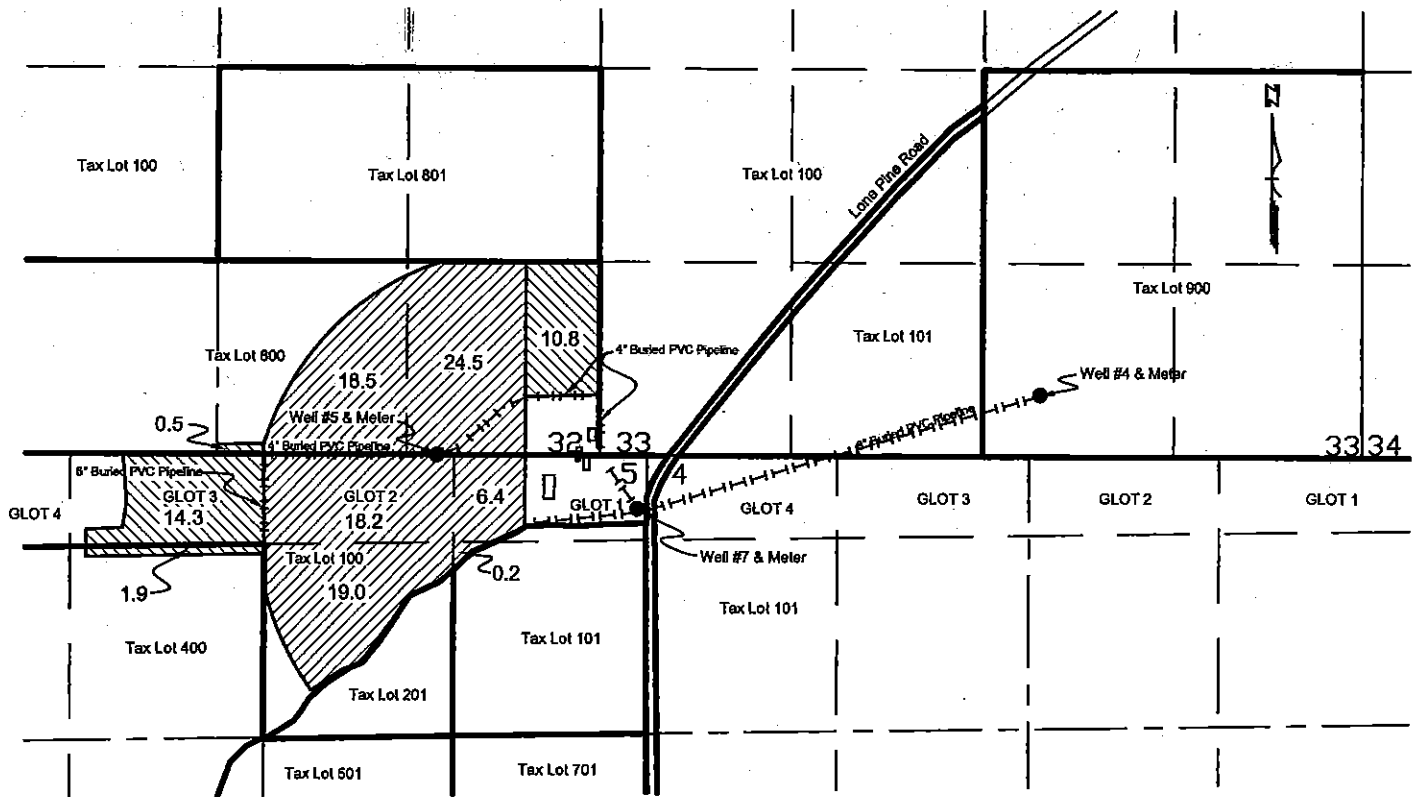

Township 14 South, Range 14 East from the Willamette Meridian
Crook County

Map Legend

- — — — — Quarter Quarter Section Line
- - - - - Half Section Line
- — — — — Section Line
- — — — — Tax Lot Boundary Line
-  - Acres Irrigated from Well #4 and #7
-  - Acres Irrigated from Well #4 and Well #5

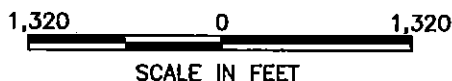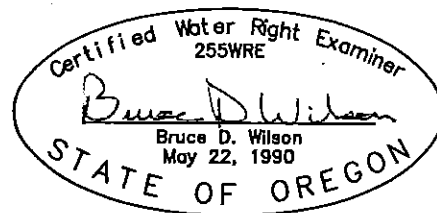

CLAIM OF BENEFICIAL USE MAP

FOR
Application G-12176 Permit G-17116
in the name of

AJ Dairy LLC

Well #4 is 420 Feet North and 2,240 Feet West from the Southeast corner of Section 33, Township 13 South, Range 14 East from the Willamette Meridian.
Well #5 is 3 Feet South and 1,113 Feet West from the Southeast corner of Section 32, Township 14 South, Range 14 East from the Willamette Meridian.
Well #7 is 365 Feet South and 260 Feet East from the Southeast corner of Section 32, Township 14 South, Range 14 East from the Willamette Meridian.

NOTE: THIS MAP WAS PREPARED FOR THE PURPOSE OF IDENTIFYING THE LOCATION OF A WATER RIGHT ONLY
AND IS NOT INTENDED TO PROVIDE LEGAL DIMENSIONS OR LOCATION OF PROPERTY OWNERSHIP LINES.