


T. 7 S. R. 39 E., W.M.

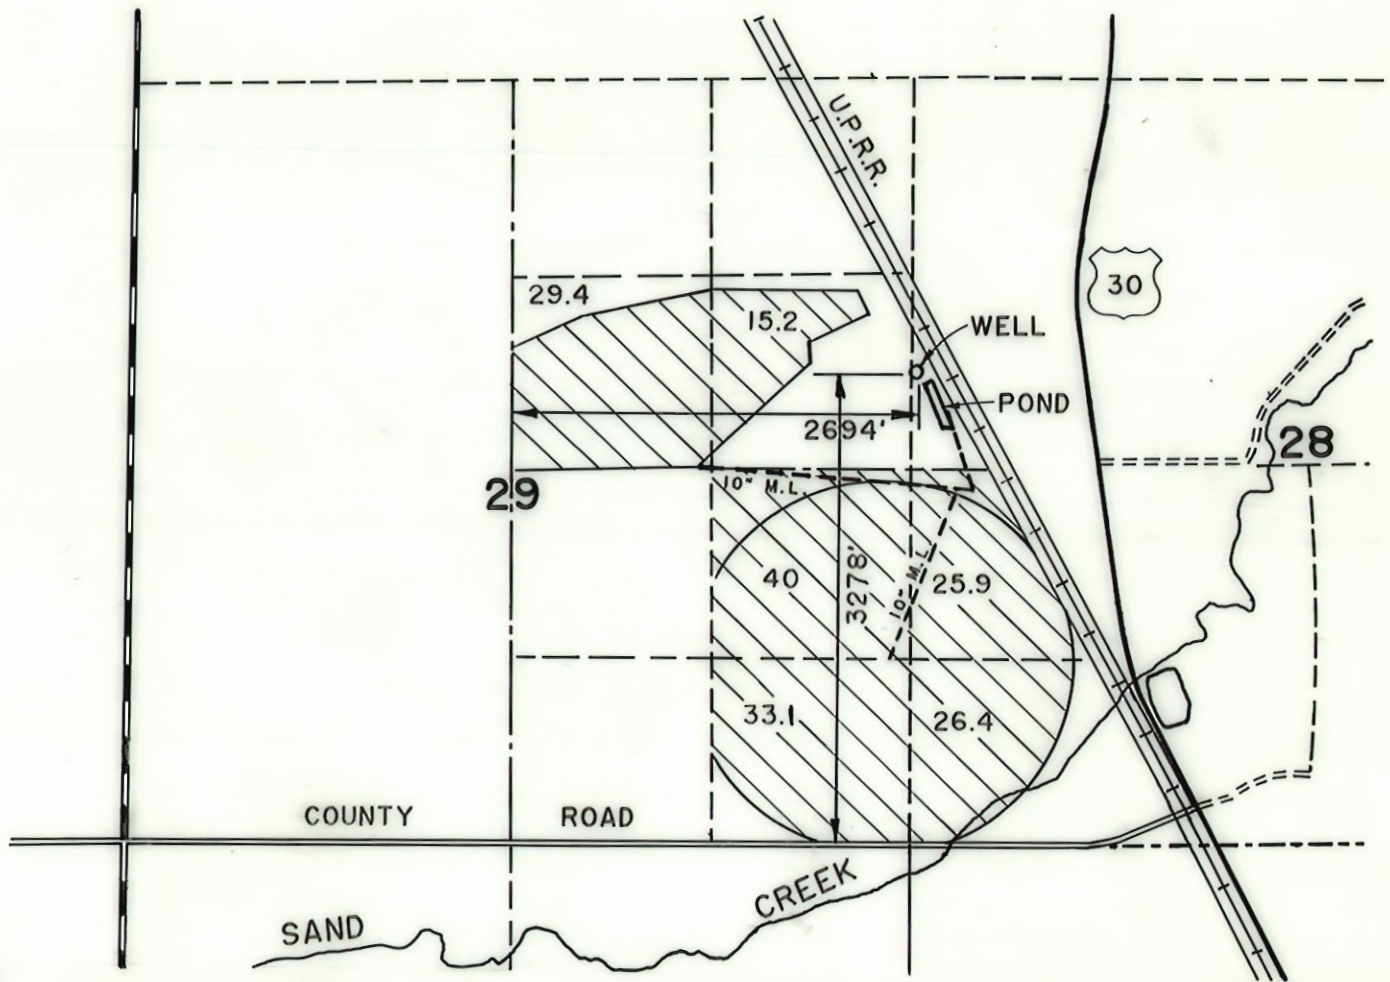

SCALE 1" = 1320'

The purpose of this map is for identifying the location of the water right only and is not intended to provide legal dimensions of property ownership lines.

FINAL PROOF SURVEY

UNDER

Application No. G-12266 Permit No. G-11219

IN NAME OF

L.M. and M.S. Ingram Trust

Surveyed September 20, 1995

RECEIVED

SEP 28 1995

WATER RESOURCES DEPT.
SALEM, OREGON

