


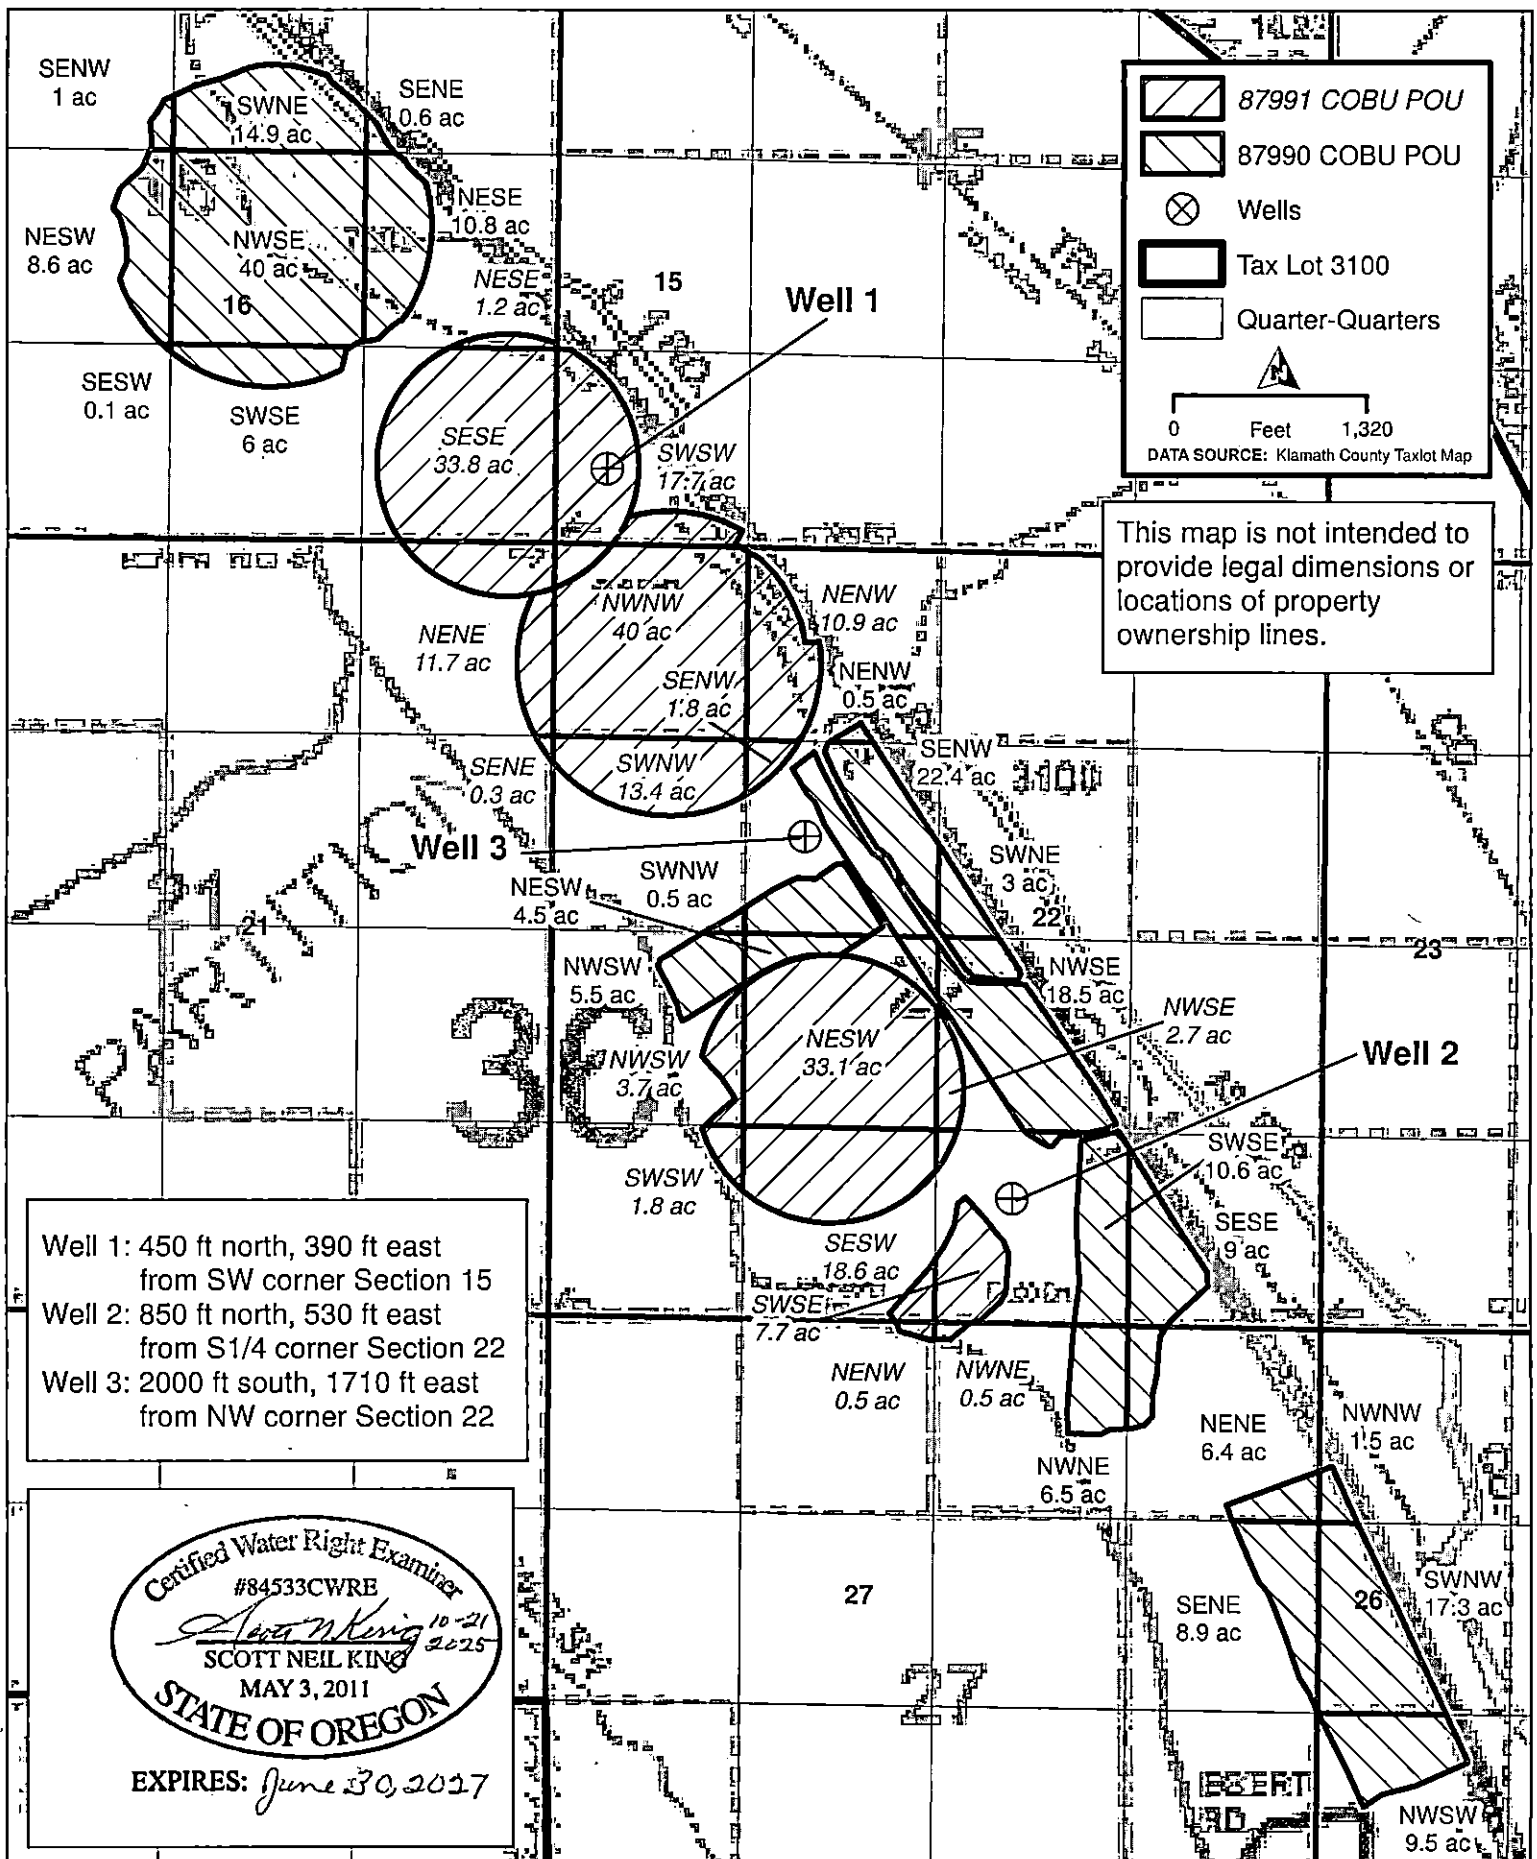

T 37 S R 11 1/2 E W.M.  
 Sections 15, 16, 22, 26, 27  
 Klamath County Tax Lot 3100

**CLAIM OF BENEFICIAL USE MAP**

T-12762

AMARAL CHAPMAN RANCH LLC

(REPORT NAME)