


RECEIVED

NOV 17 1995

WATER RESOURCES DEPT.
SALEM, OREGON

T.4&5S., R.3W., W.M.

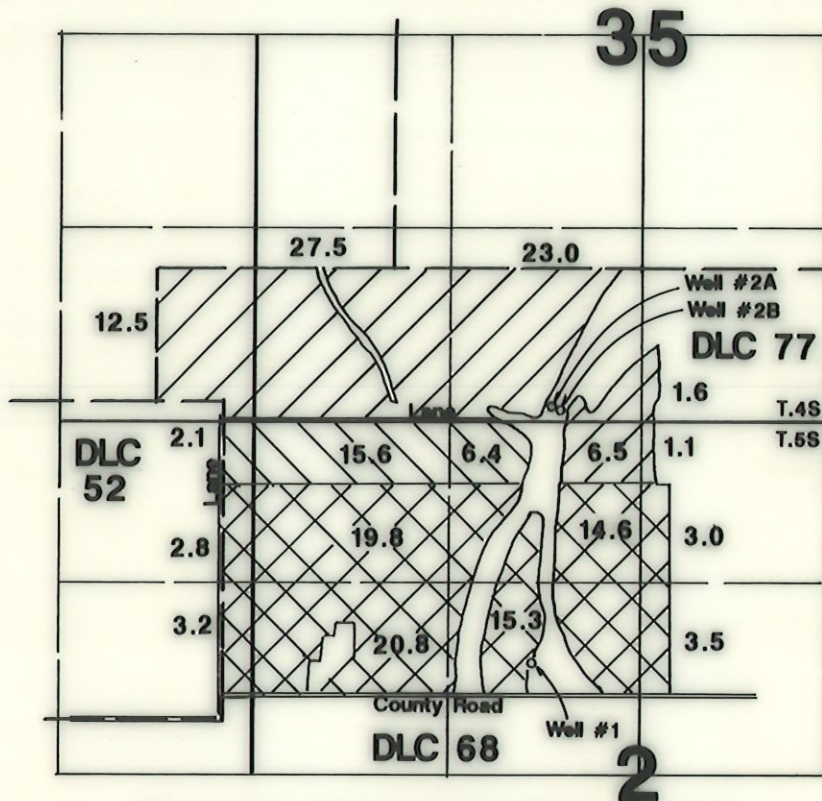

Well #1 located 363'N & 2112'E from SE corner DLC 52.
Well #2A located 97'N & 2050'E from SW corner Section 35.
Well #2B located 82'N & 2064'E from SW corner Section 35.

1" = 1320'

Wells 2A/2B
(72.2 acres)

Well #1
(24.1 acres)

Well #1
-Bring to full duty
over Cert. #29576
(83.0 acres)

Final Proof Survey

Application #: G-12178 Permit #: G-11557

In Name Of

Dorothy M. Adams

Surveyed on November 14, 1995 by JM Schuette

THIS MAP WAS PREPARED FOR THE PURPOSE OF
IDENTIFYING THE LOCATION OF A WATER RIGHT
ONLY AND IS NOT INTENDED TO PROVIDE LEGAL
DIMENSIONS OR LOCATION OF PROPERTY
OWNERSHIP LINES.

