
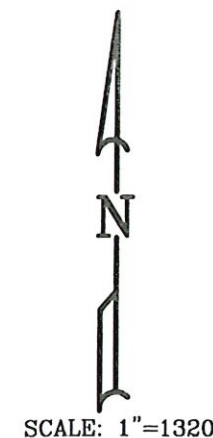
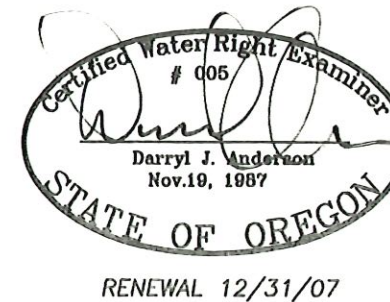


CLAIM OF BENEFICIAL USE MAP

FOR

KENNETH D. & CONNIE S. MASTEN

SECTION 18, TOWNSHIP 39 SOUTH RANGE 11 EAST,
KLAMATH COUNTY, OREGON

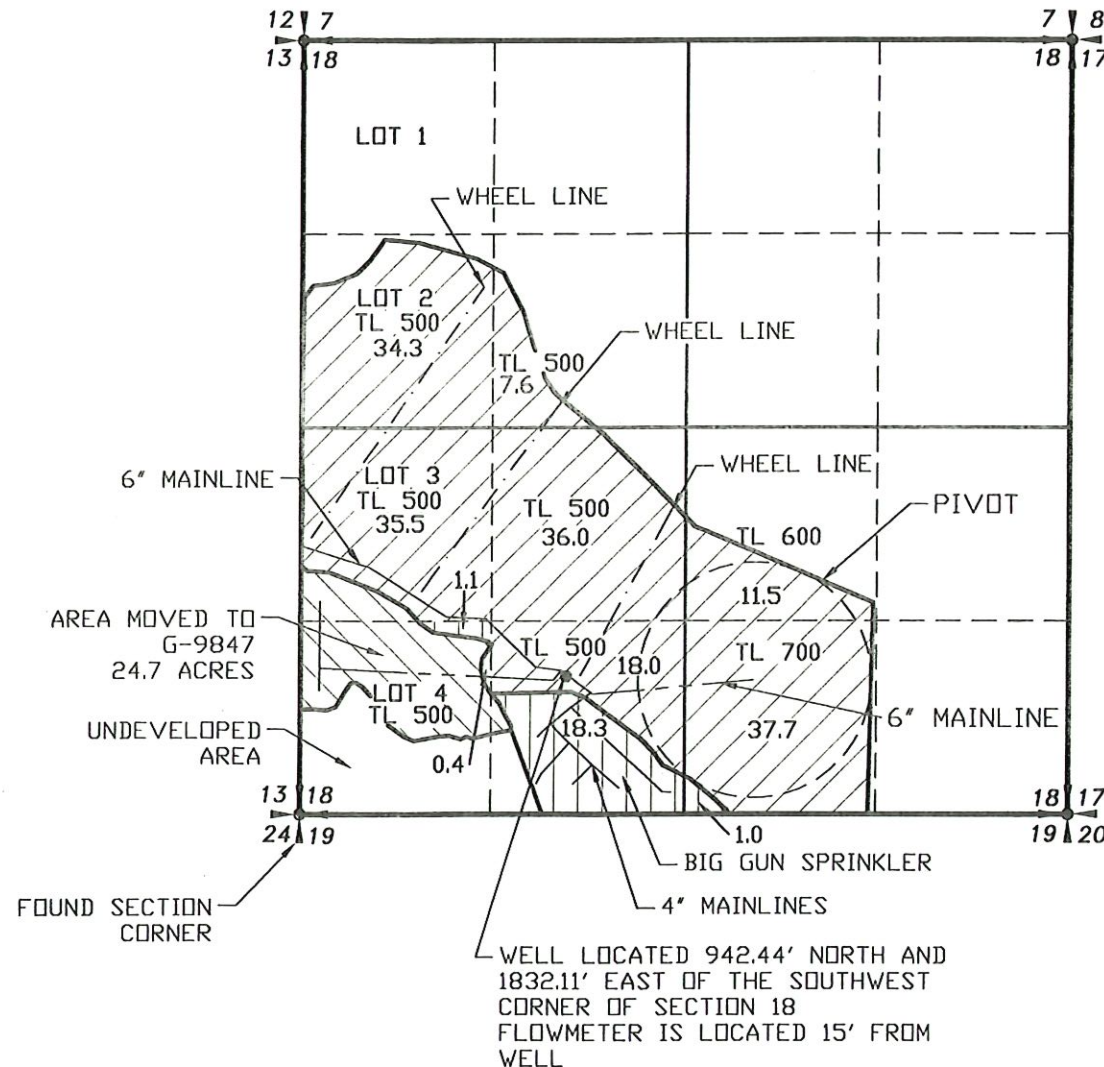

LEGEND

- SECTION LINE
- 1/4 SECTION LINE
- 1/16 SECTION LINE
- IRRIGATION MAIN LINE
- WHEEL LINE
- PRIMARY IRRIGATION
- SUPPLEMENTAL IRRIGATION
- AREA MOVED TO G-9847

PERMIT NO. G-12452

APPLICATION NO. G-12874

RECEIVED

JUL 27 2007

WATER RESOURCES DEPT
SALEM, OREGON

NOTE:
PREPARATION OF THIS MAP IS FOR IDENTIFYING PROPOSED
WATER RIGHTS ONLY. IT HAS NO INTENT TO PROVIDE
LOCATIONS OR DIMENSIONS OF PROPERTY BOUNDARIES.

COBU MAP # 0277

REVISION	BY

ANDERSON ENGINEERING
AND SURVEYING, INC.
P.O. BOX 28
LAKEVIEW, OREGON
97630 (541)
947-4407 FAX
947-2321

FOR:
KENNETH D. &
CONNIE S. MASTEN
ET. 2, BOX 21
BONANZA, OR 97623

CLAIM OF BENEFICIAL USE
PERMIT NO. G-12452
APP. NO. G-12874

DATE:	2/27/2007
SCALE:	1"=1320'
DWG. BY:	R.C.
JOB:	G-12443
FILE:	2006-128
SHEET:	1 OF 1