


CLAIM OF BENEFICIAL USE MAP

FOR

KENNETH & CONNIE MASTEN


SECTIONS 2, 3, 10, AND 11, TOWNSHIP 39 SOUTH RANGE 11 EAST,
KLAMATH COUNTY, OREGON

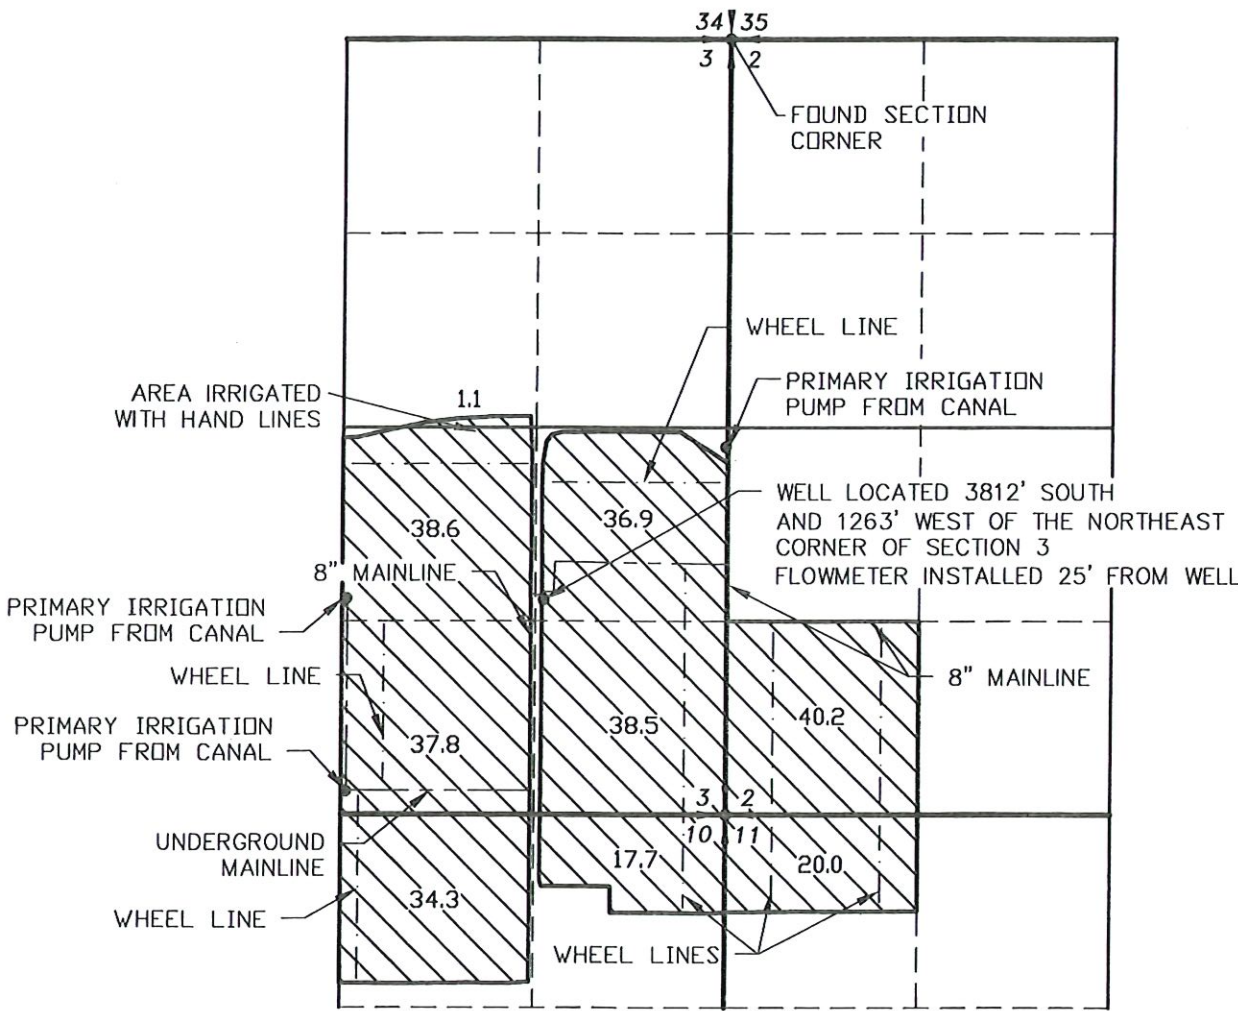

RENEWAL 12/31/07

LEGEND

- SECTION LINE
- 1/4 SECTION LINE
- 1/16 SECTION LINE
- IRRIGATION MAIN LINE
- WHEEL LINE
- AREA IRRIGATED

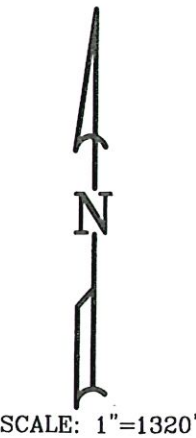

SCALE: 1"=1320'

PERMIT NO. G-12453

NOTE:
PREPARATION OF THIS MAP IS FOR IDENTIFYING PROPOSED
WATER RIGHTS ONLY. IT HAS NO INTENT TO PROVIDE
LOCATIONS OR DIMENSIONS OF PROPERTY BOUNDARIES.

RECEIVED
MAR 12 2007
WATER RESOURCES DEPT
SALEM, OREGON

COBU MAP #0244

REVISION	BY

ANDERSON ENGINEERING
AND SURVEYING, INC.
P.O. BOX 28
LAKEVIEW, OREGON
97630 (541)
947-4407 FAX
947-2321

FOR: KEN MASTEN
4550 BURGDOFF RD.
BONANZA, OR. 97623
(541)545-6128

CLAIM OF BENEFICIAL USE
PERMIT NO. G-12453
APPLICATION NO. G-12876

DATE:	FEB 2007
SCALE:	1"=1320'
DWG. BY:	J.E.H.
JOB:	2006-128
FILE:	G-12453
SHEET:	1