


SINGHOSE – RILEY RANCH
FINAL PROOF MAP – G-13698
LOCATED IN SECTIONS 22, 23 & 24,
T. 24 S., R. 27 E., W.M., HARNEY COUNTY, OREGON

WELL 1V (60 HP) LOCATED
 APPROX. S 220' & W 485'
 FROM NE COR SECTION 22

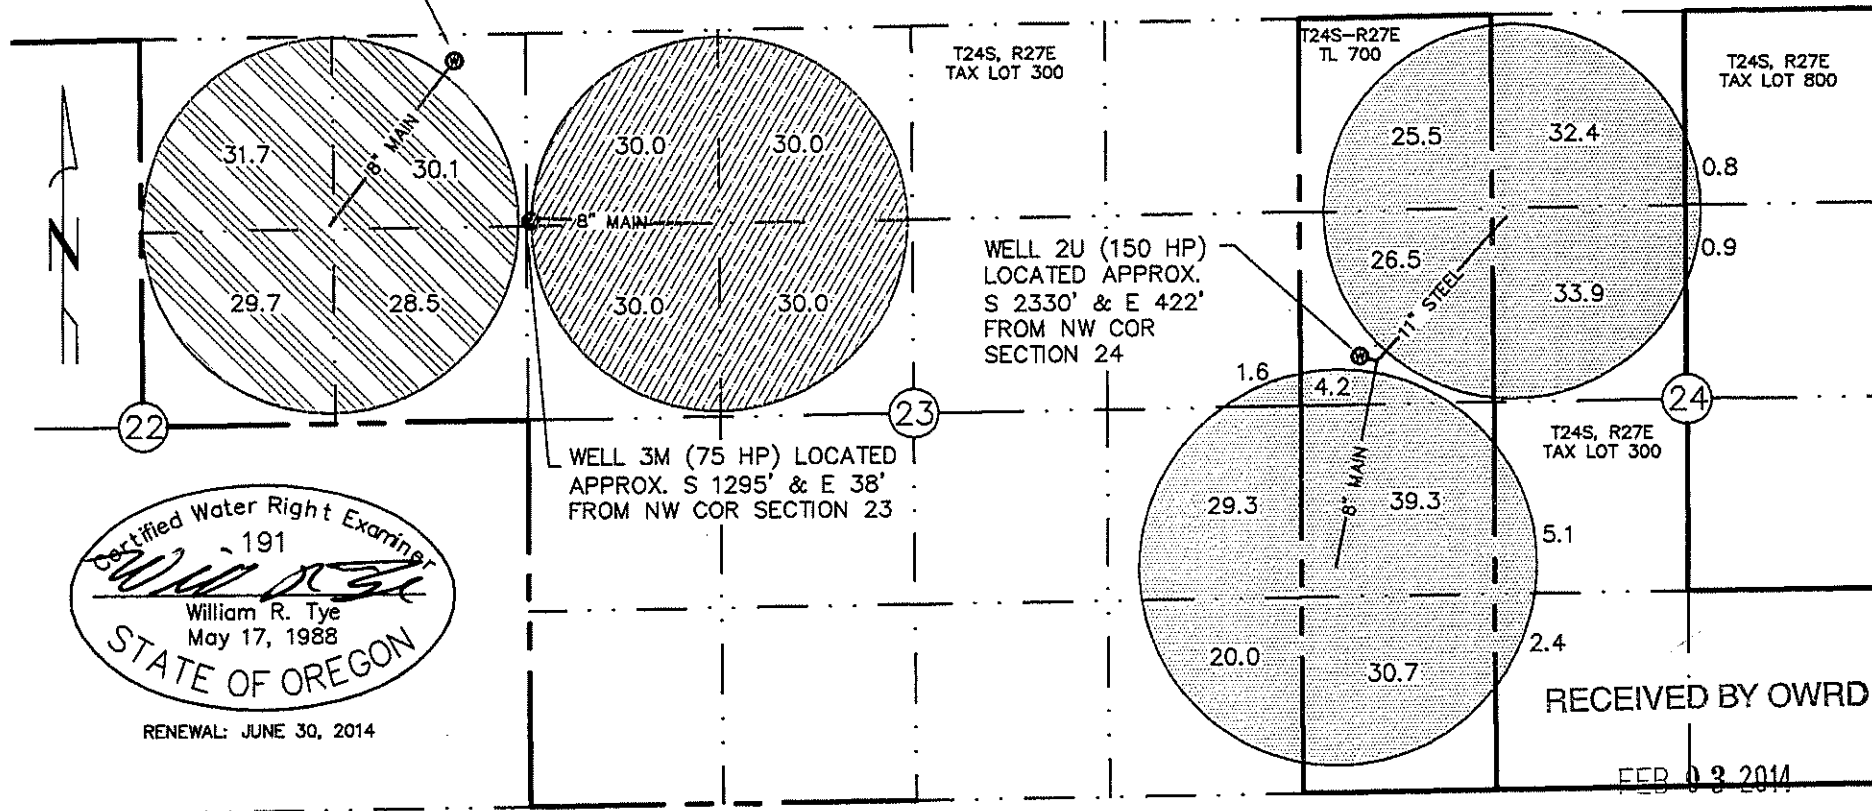


-  G-13698-1V WELL-120.0 AC
-  G-13698-2U WELL-252.6 AC
-  G-13698-3M WELL-120.0 AC

G-13698 PERMIT – 492.6 AC TOTAL

I, WILLIAM R. TYE, CERTIFIED WATER RIGHT EXAMINER IN THE STATE OF OREGON, HEREBY CERTIFY THIS FINAL PROOF MAP WAS PREPARED UNDER MY DIRECT SUPERVISION.

THE PREPARATION OF THIS MAP IS FOR THE PURPOSE OF IDENTIFYING THE LOCATION OF THE WATER RIGHT ONLY AND HAS NO INTENT TO PROVIDE DIMENSIONS OR LOCATIONS OF PROPERTY OWNERSHIP LINES.

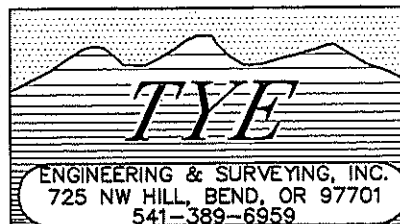

SALEM, OR

1812_G-13698_COBU_1-7-14.DWG

TITLE: SINGHOSE G-13698	
JOB NO: 1812-SINGHOSE	
SCALE: 1"=1320	DRAWN BY: P.A.T.
FIELD BOOK NO:	DATE: 1/7/13
DWG NAME:	SHEET: 1 OF 1