
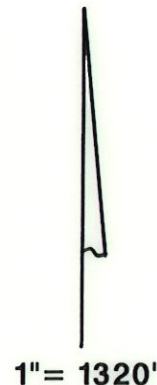


T.7S., R.1W., W.M.

RECEIVED

JUL 8 1996

**WATER RESOURCES DEPT.
SALEM, OREGON**

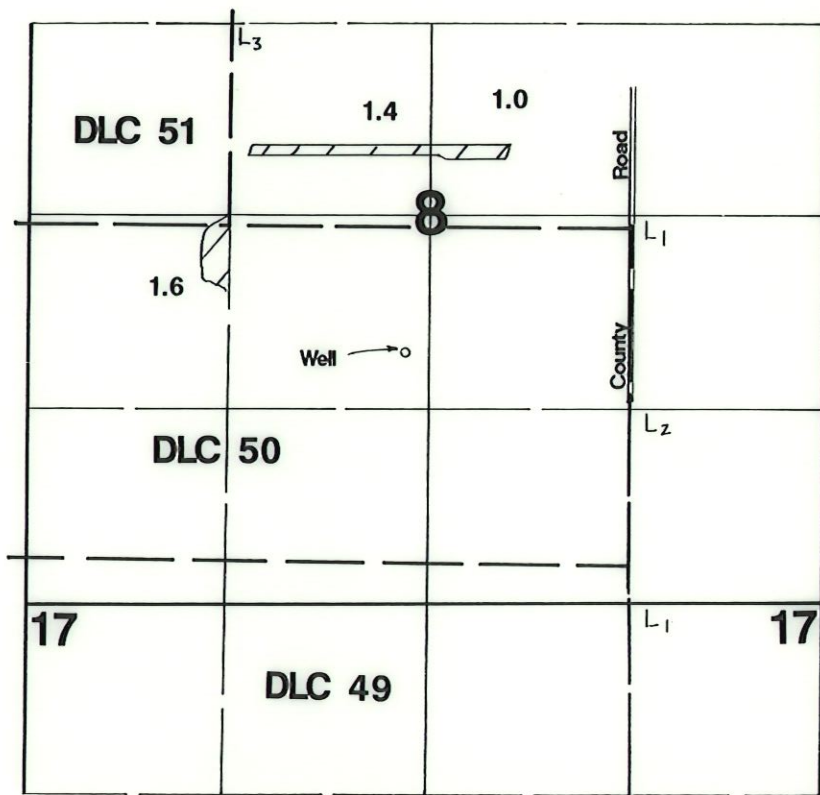

Well located 940'S & 180'W from center 1/4 corner Section 8.


Final Proof Survey

Application #: G-13327 Permit #: G-11847

In Name Of

Melvin Kaufman

Surveyed on July 20, 1995 by Jim Grimm

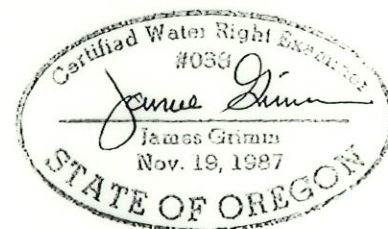

THIS MAP WAS PREPARED FOR THE PURPOSE OF IDENTIFYING THE LOCATION OF A WATER RIGHT ONLY AND IS NOT INTENDED TO PROVIDE LEGAL DIMENSIONS OR LOCATION OF PROPERTY OWNERSHIP LINES.