

FINAL PROOF SURVEY

RECEIVED

JUL 31 1997

AND

WATER RESOURCES DEPT.
TALEM, OREGON

CLAIM OF BENEFICIAL USE


LOCATED IN

NW 1/4, NW 1/4, SECTION 16, T2N, R32E, WM
UMATILLA COUNTY, OREGON


APPLICATION G-13634

PERMIT G-12061

BERT L. and DOROTHY M. JONES

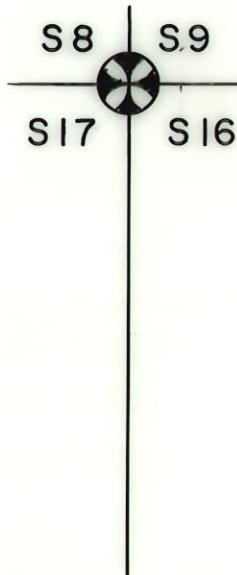

NW 1/4, NW 1/4
Section 16

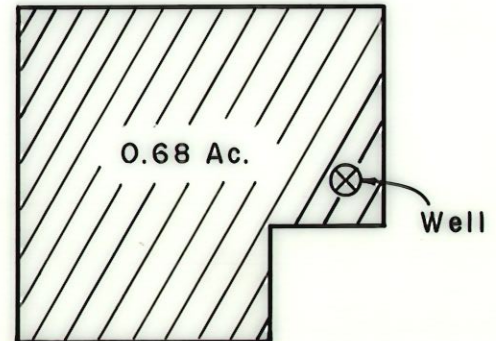

Legend

 Area under irrigation:
NW 1/4, NW 1/4
Section 16:
0.68 Acres


 Well, located
220' South and
533' East of
NW corner of
Sec. 16, T2N, R32E



0 50 100
Scale: 1" = 100'

Area beneficially irrigated: 0.68 Ac.

This map is prepared for the express purpose to show water appropriation and use. It is not intended to show or locate property ownership lines.

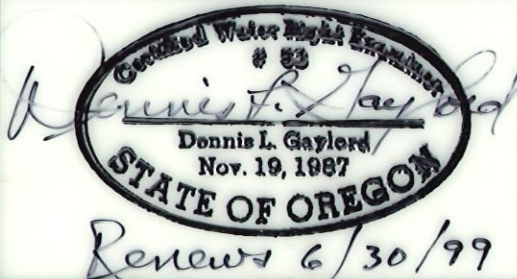

Dennis L. Gaylord, CWRE
4107 S.W. Lake Drive
Pendleton, OR 97801
1 (541) 276-6260

Drawn: D. Messer

©