

FINAL PROOF SURVEY
AND
CLAIM OF BENEFICIAL USE

RECEIVED

JUL 31 1997


WATER RESOURCES DEPT.
HELM, OREGON

LOCATED IN
SW1/4, SW1/4 SECTION 9
AND
NW1/4, NW1/4, SECTION 16
T2N, R32E, W.M.
UMATILLA COUNTY, OREGON

APPLICATION G-13633

PERMIT G-12388

SAM and MARCENE JONES

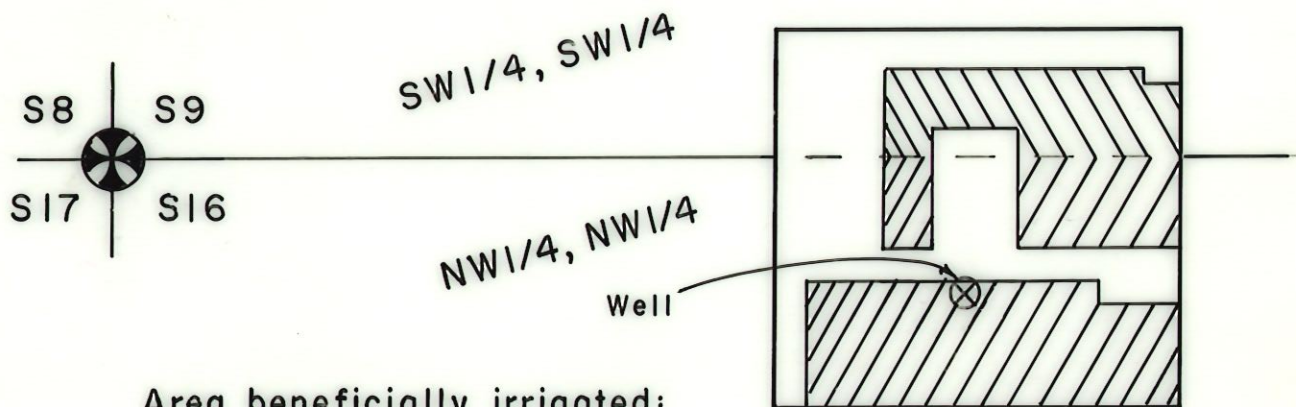


Legend

- Area under irrigation
SW1/4, SW1/4 Sec. 9:
0.14 Acre
- Area under irrigation
NW1/4, NW1/4 Sec. 16:
0.38 Acre
- Well, located 70' South
and 445' East of the
SW corner of Section
9, T2N, R32E, W.M.



This map is prepared for the express purpose to show water appropriation and use. It is not intended to show or locate property ownership lines.

©

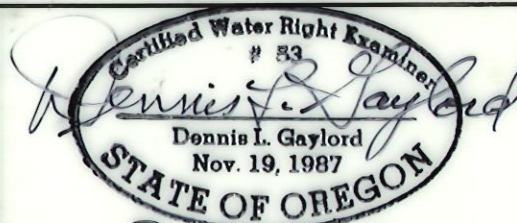

Dennis L. Gaylord, CWRE
4107 S.W. Lake Drive
Pendleton, OR 97801
1 (541) 276-6260
Drawn: D. Messer