

FINAL PROOF SURVEY UNDER

APPLICATION #G-11734 PERMIT #11535
SITUATED IN SECTIONS 19 AND 30
T40S, R14EWM, KLAMATH COUNTY, OREGON.

SEPTEMBER 1996

RECEIVED



SEP 27 1996

WATER RESOURCES DEPT.
SALEM, OREGON

MAP PREPARED FOR
FRANK HAMMERICH

LOCATION OF WELL BY FIELD SURVEY
1839 FEET NORTH AND 826 FEET WEST OF THE
SECTION CORNER COMMON TO
SECTIONS 19, 20, 30 AND 29

MAP PREPARED FROM R.O.S. 4845, FIELD SURVEY,
APPLICATION MAP FOR APPLICATION #G-11734, AERIAL PHOTO,
KLAMATH ADJUDICATION MAP AND MAP TO ACCOMPANY ABSTRACT
OF DECREE #2298

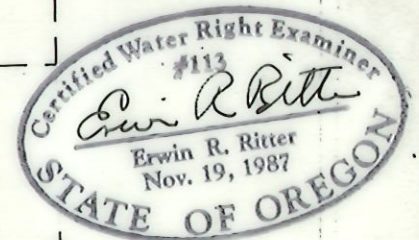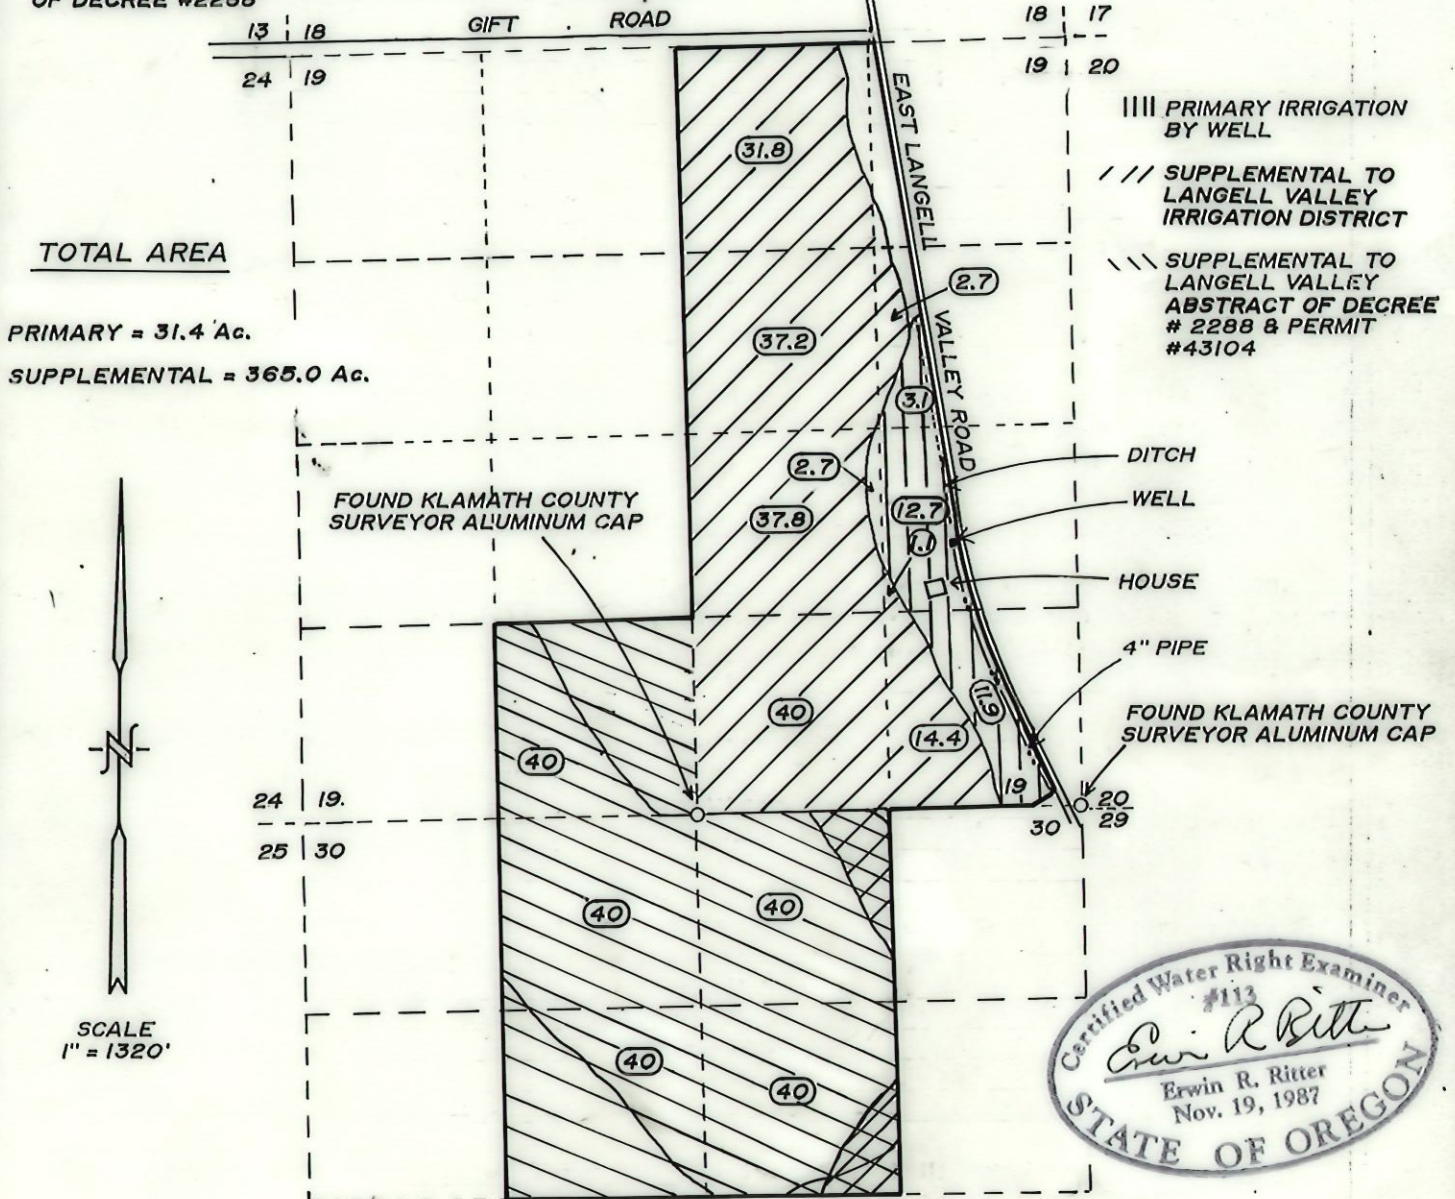

THE PURPOSE OF THIS MAP IS TO IDENTIFY THE LOCATION OF
THE WATER RIGHT. IT IS NOT INTENDED TO PROVIDE INFORMATION
RELATIVE TO THE LOCATION OF PROPERTY OWNERSHIP BOUNDARY
LINES.

TRU-LINE SURVEYING, INC.
2333 SUMMERS LANE
KLAMATH FALLS, OR. 97603