
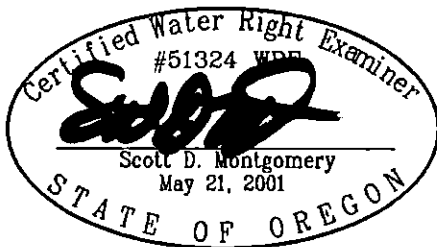


CLAIM OF BENEFICIAL USE MAP

TO ADD PLACE OF USE FOR STORAGE
PER APPLICATION R-36326
OREGON DEPARTMENT OF STATE LANDS


Rev. 10
OCT 27 2025

NE 1/4 SECTION 27, TOWNSHIP 27 SOUTH, RANGE 24 EAST, W.M.
TAX LOT: 100, HARNEY COUNTY, OREGON

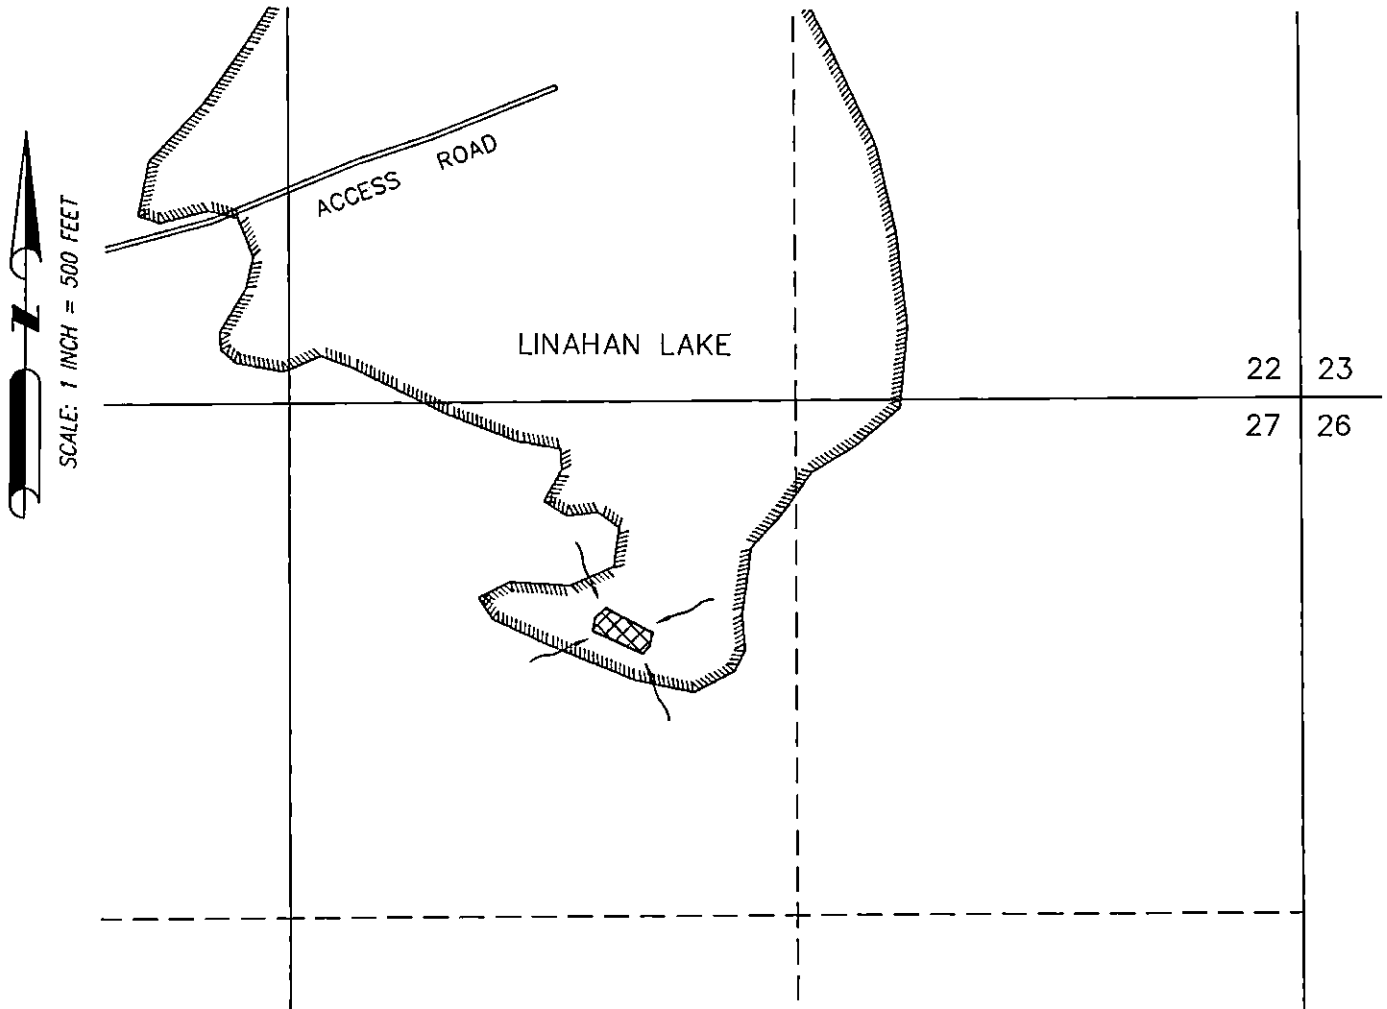

RENEWAL DATE: 12/31/2026

SLOPPY

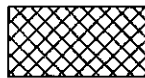

0.3 ACRE-FEET STO WITHIN NW
1/4 NE 1/4 SECTION 27 FROM
SEASONAL RUNOFF, AS SHOWN.

POD AT CENTER OF PIT IS LOCATED 600' S
& 1760' W FROM NE CORNER OF SECTION 27.

THIS MAP IS FOR THE PURPOSE OF LOCATING A WATER RIGHT ONLY AND HAS NO
INTENT TO PROVIDE LEGAL DIMENSIONS OR THE LOCATION OF PROPERTY LINES.

PREPARED FOR:

OREGON DEPARTMENT OF STATE LANDS
775 SUMMER STREET NE #100
SALEM, OR 97301

PREPARED BY:



ALL POINTS ENGINEERING AND SURVEYING, INC.
P.O. BOX 767 TERREBONNE, OR 97760
(541) 548-5833
www.APEandS.com