
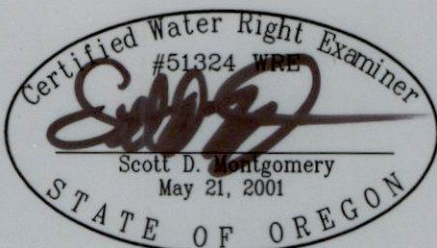


CLAIM OF BENEFICIAL USE MAP

TO ADD PLACE OF USE FOR STORAGE
PER APPLICATION R-36334
OREGON DEPARTMENT OF STATE LANDS

NW 1/4 SECTION 25, TOWNSHIP 27 SOUTH, RANGE 24 EAST, W.M.
TAX LOT: 100, HARNEY COUNTY, OREGON

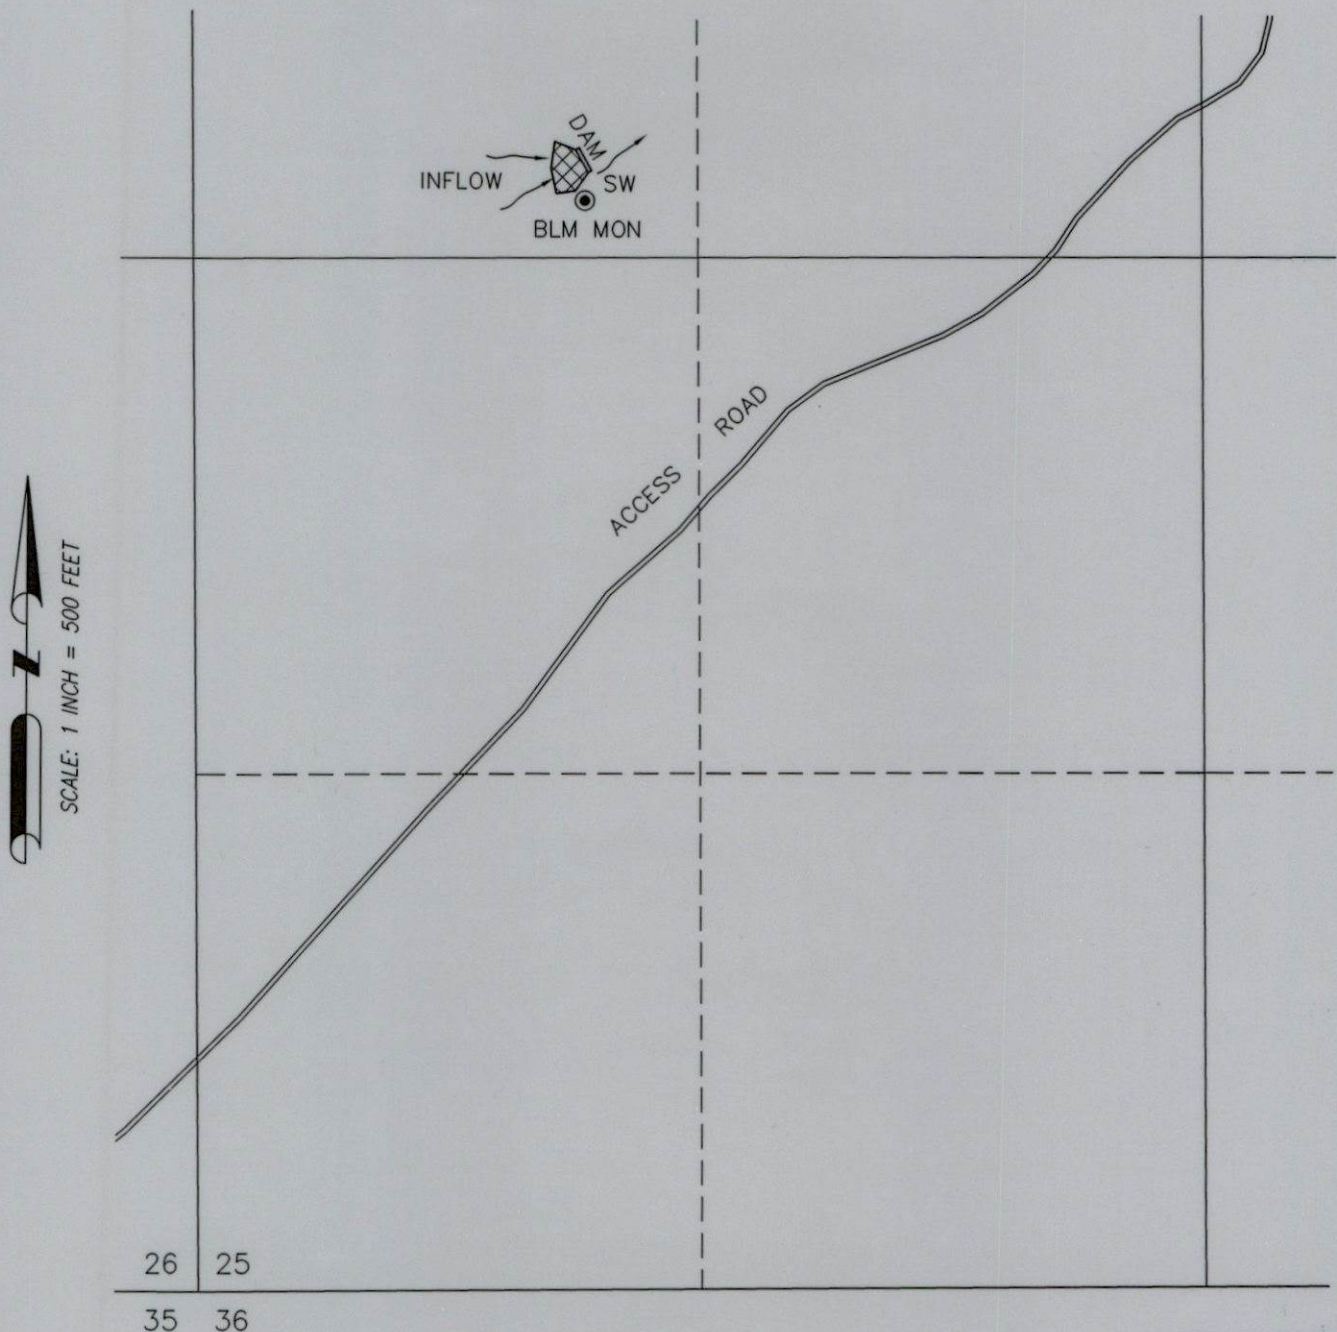

RENEWAL DATE: 12/31/2026



STORMY

0.8 ACRE-Feet STO WITHIN SW
1/4 NW 1/4 SECTION 25 FROM
SEASONAL RUNOFF, AS SHOWN.

POD AT CENTER OF DAM IS LOCATED 2915' N
& 1020' E FROM SW CORNER OF SECTION 25.

Received
OCT 27 2025

OWRD