


T.5S. R.1W. Sec. 33 & 34, W.M.

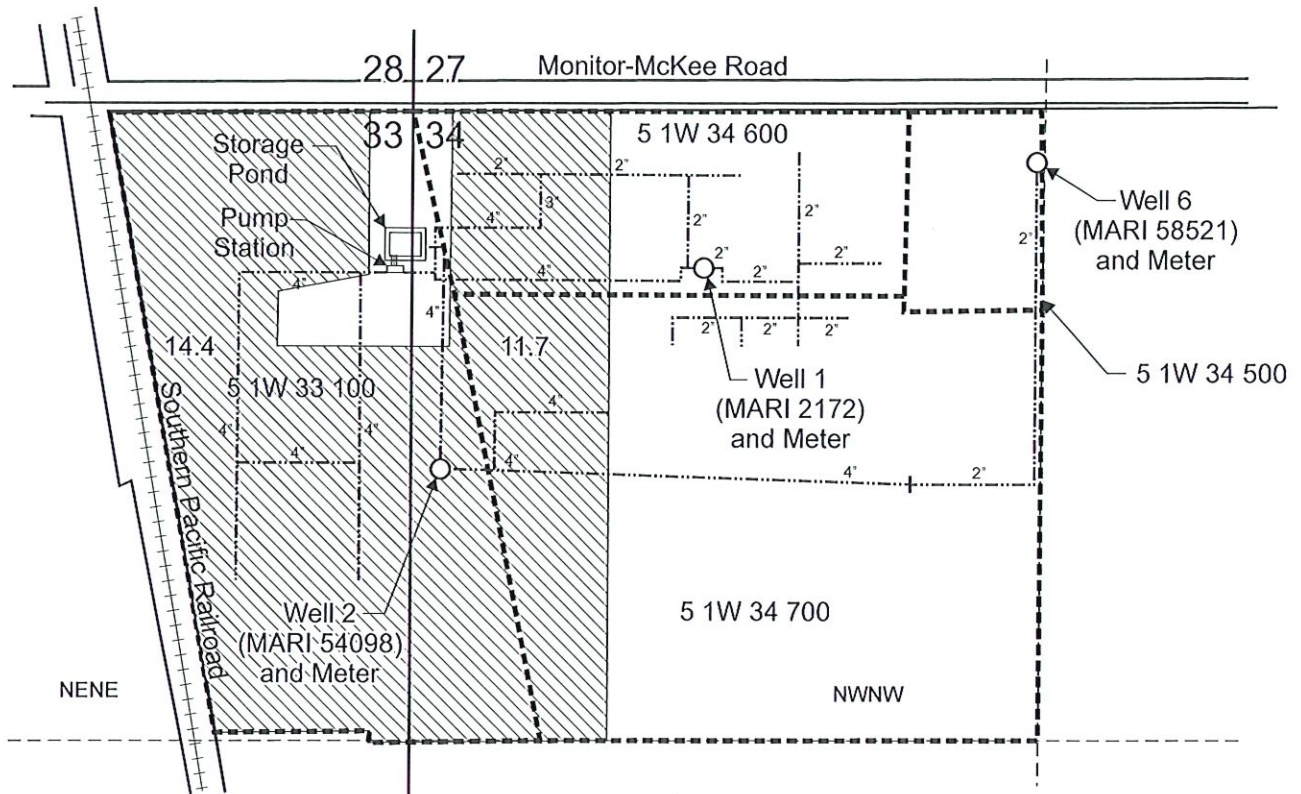


Well 1 (MARI 2172) is located 340 feet south and 610 feet east from the NW corner of Section 34.
 Well 2 (MARI 54098) is located 760 feet south and 60 feet east from the NW corner of Section 34.
 Well 6 (MARI 58521) is located 120 feet south and 1,300 feet east from the NW corner of Section 34.

Area (26.1 acres) of nursery use under Application G-15785, Permit G-15676.


Tax lot boundary

Irrigation main line

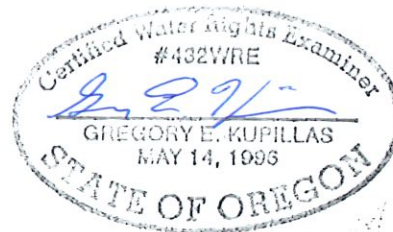

EXPIRATION DATE: 6/30/2027

Scale: 1" = 400'

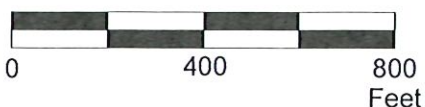

This map was prepared for the purpose of identifying the location of a water right only and is not intended to provide legal dimensions or location of property ownership lines.

Claim of Beneficial Use Map
 Application G-15785, Permit G-15676

Pacific Hydro-Geology Inc.

7/2010
 Rev. 03/2026

Fessler Nursery Company
 T.5S. R.1W. Sec. 33 & 34, W.M.