


SEC. 12 & SEC. 13, T.5S, R.1W, W. M.

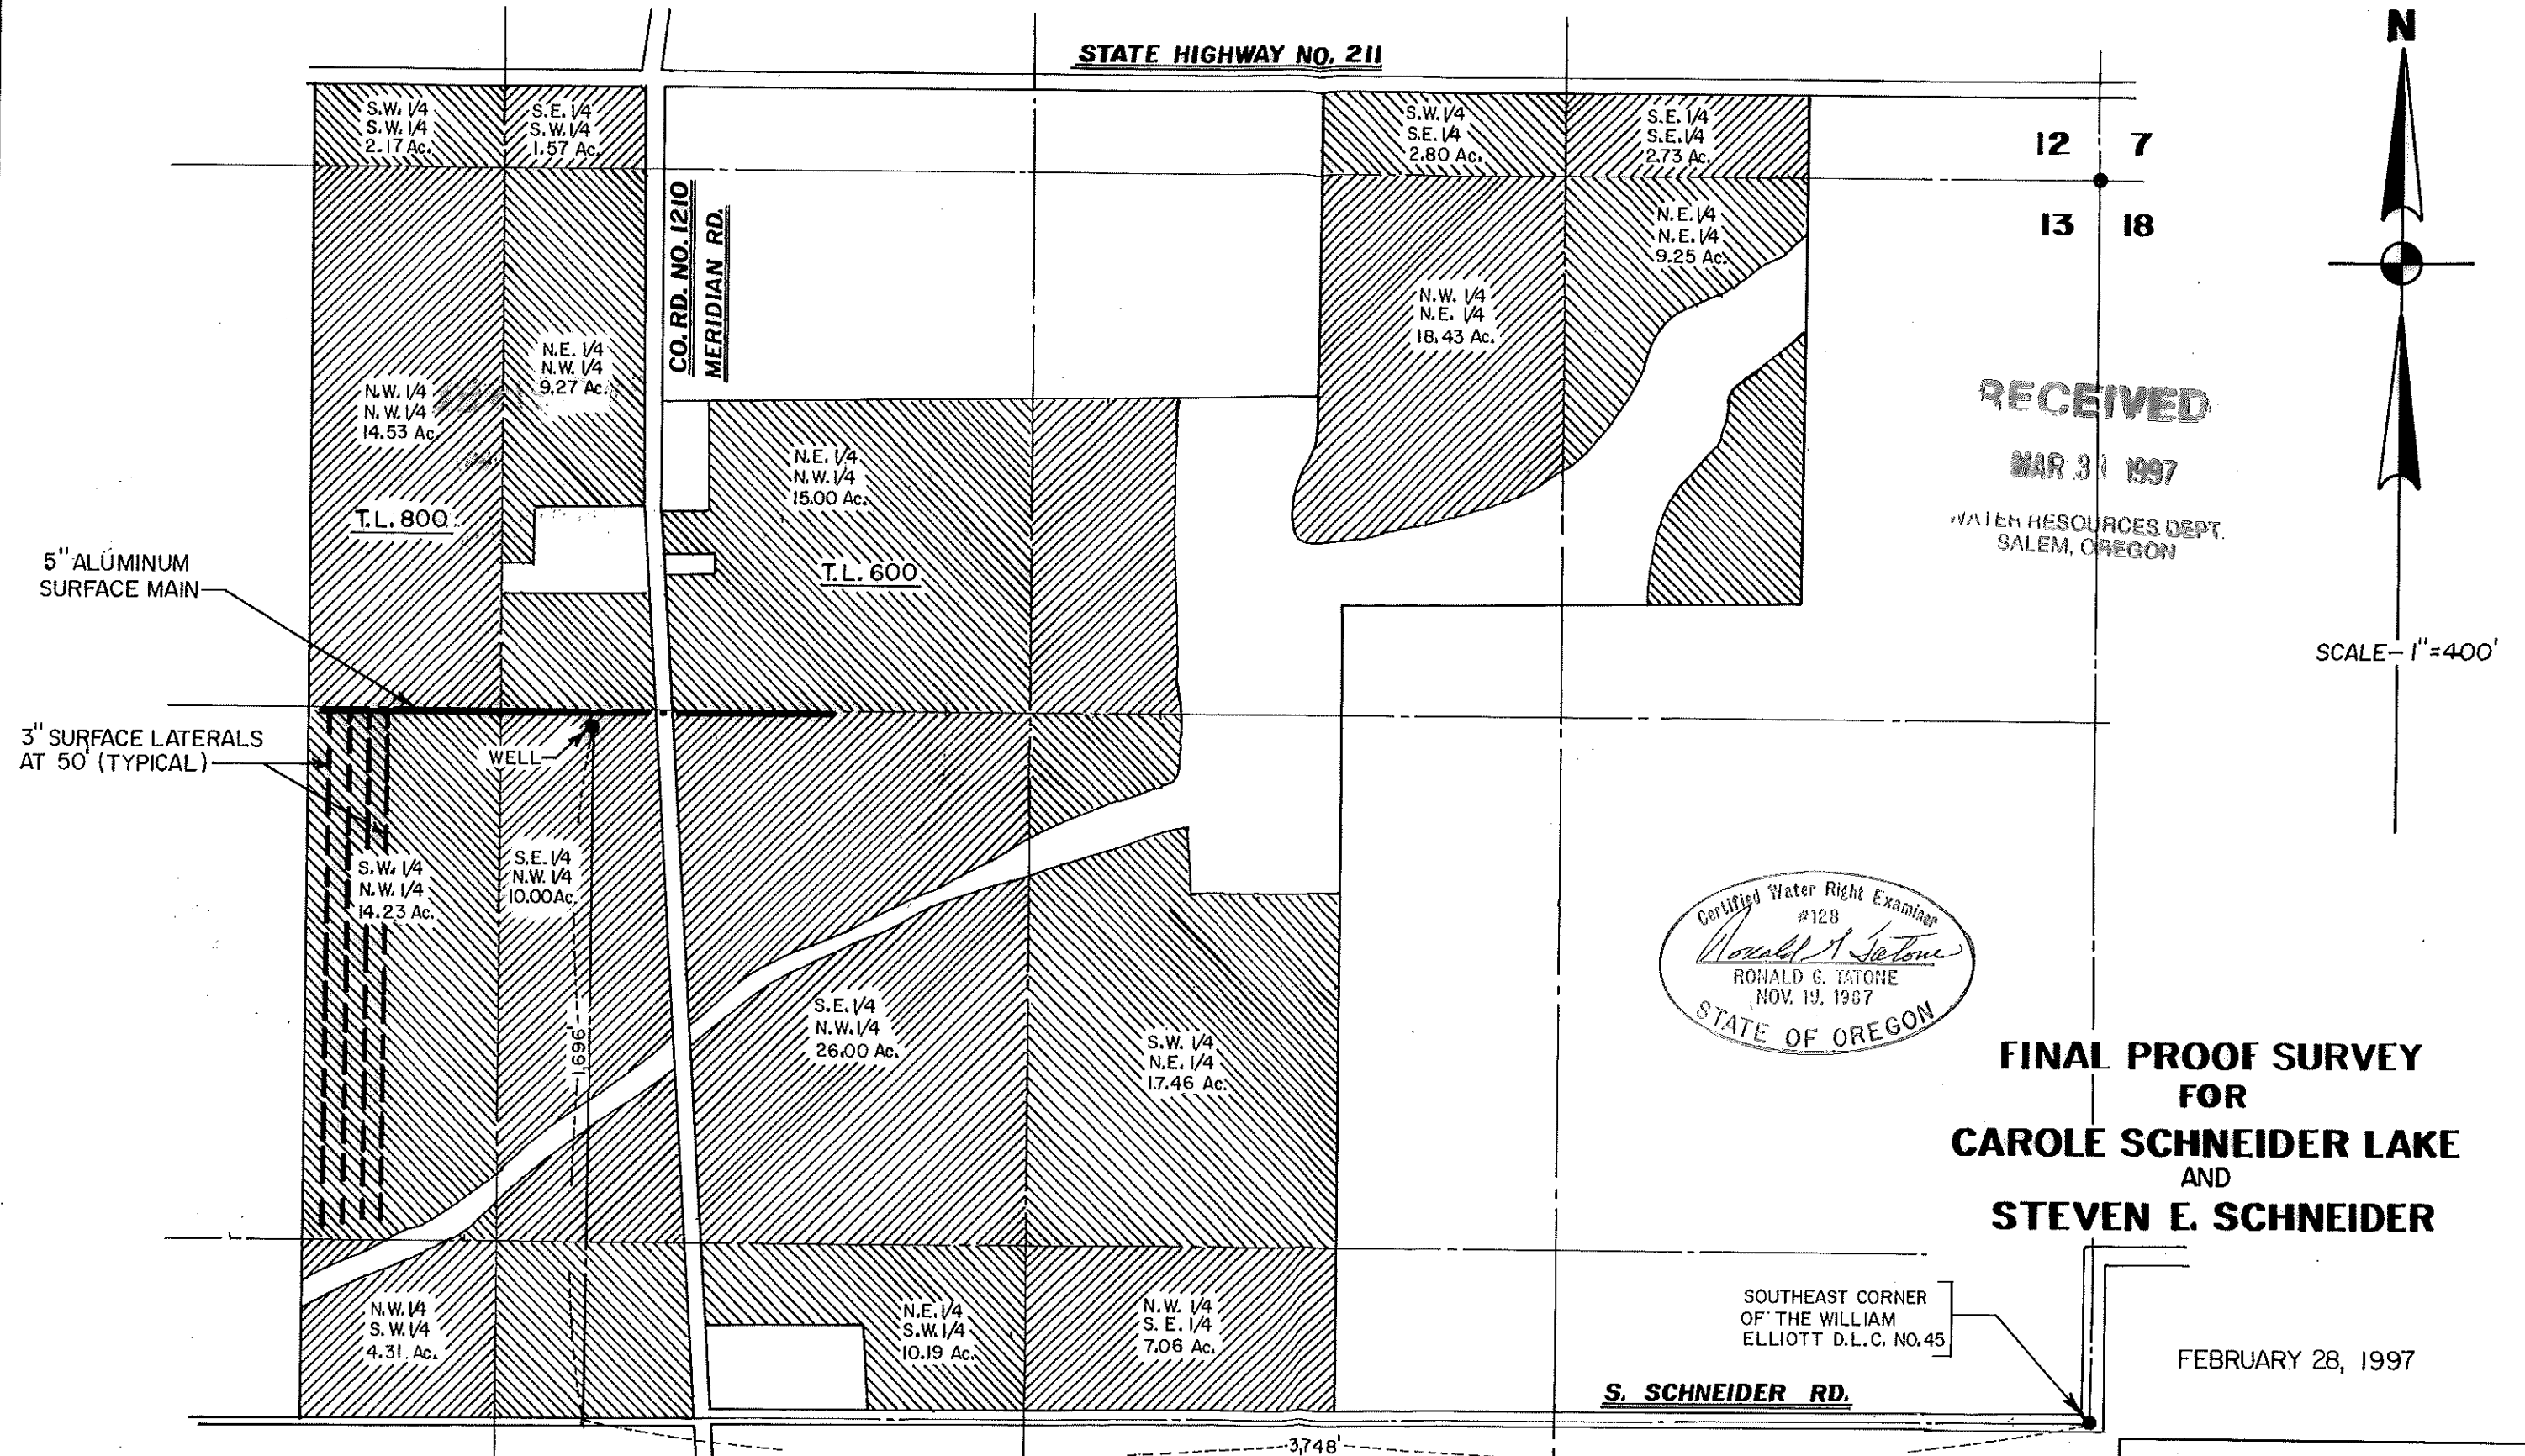

APPLICATION NO. G-13661
PERMIT NO. G-12034

ZTec ENGINEERS, INC.
3737 S.E. 8TH AVE., PORTLAND, OR. 97202
PHONE: (503) 235-8795
FAX: (503) 233-7889

FEBRUARY 28, 1997