



SECTION 20, T.11S., R.26E., W.M.
APPLICATION MAP FOR HISTORIC CHANGE IN POINT OF DIVERSION
FOR
DRISCOLL AND GEARIN FAMILY TRUST

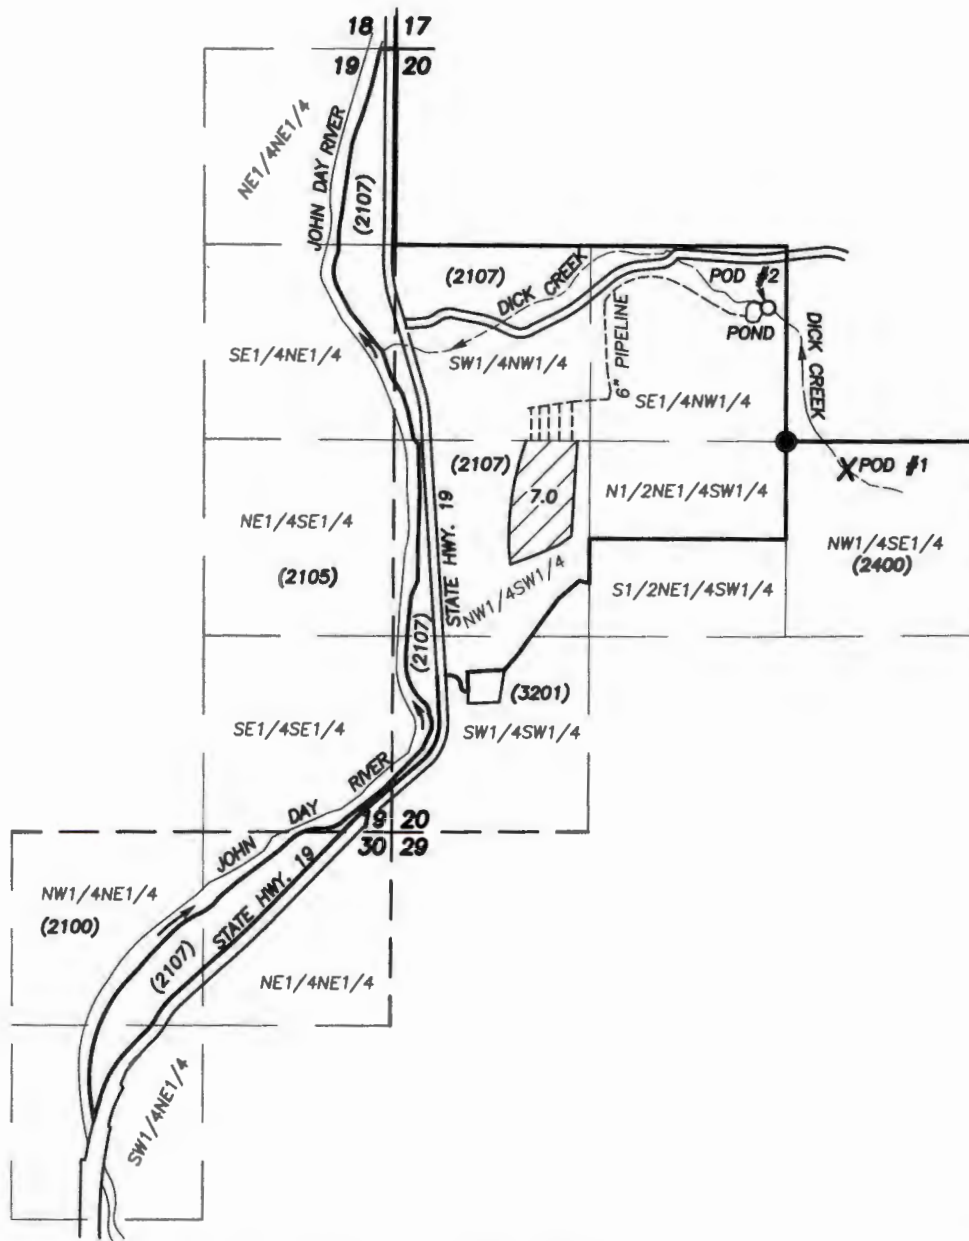

SCALE: 1" = 1320'

Received
DEC 02 2024
OWRD

PREPARED BY:
ROBERT D. BAGETT, PLS, CWRE
217 N. CANYON BLVD.
JOHN DAY, OREGON
(541) 575-1251
SEPTEMBER 18, 2024

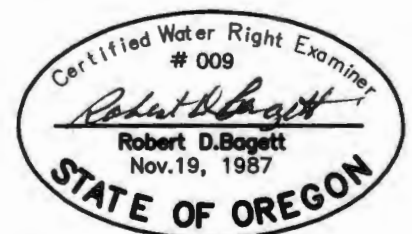

- X AUTHORIZED POD #1: ADJUDICATION MAP PLACES POD #1 IN THE NW1/4SE1/4 SECTION 20, T.11S., R.26E.,
- O PROPOSED POD #2: 915 FT. NORTH & 125 FT. WEST FROM C1/4 CORNER SECTION 20, T.11S., R.26E.
- PRIMARY: 7.0 AC. - C25510
- FOUND ALUMINUM CAP MONUMENT AT C1/4 CORNER SECTION 20, T.11S., R.26E.
- () TAX LOT NO.

DISCLAIMER: THIS MAP IS NOT INTENDED TO PROVIDE LEGAL DIMENSIONS OR LOCATIONS OF PROPERTY OWNERSHIP LINES.

14567 -

RENEWS 12/31/2025