
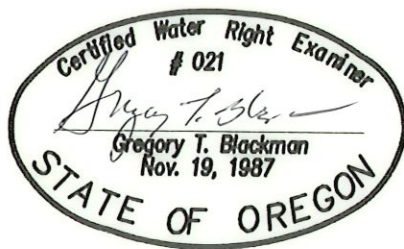


RECEIVED

JUL 26 2000

WATER RESOURCES DEPT.
SALEM, OREGON

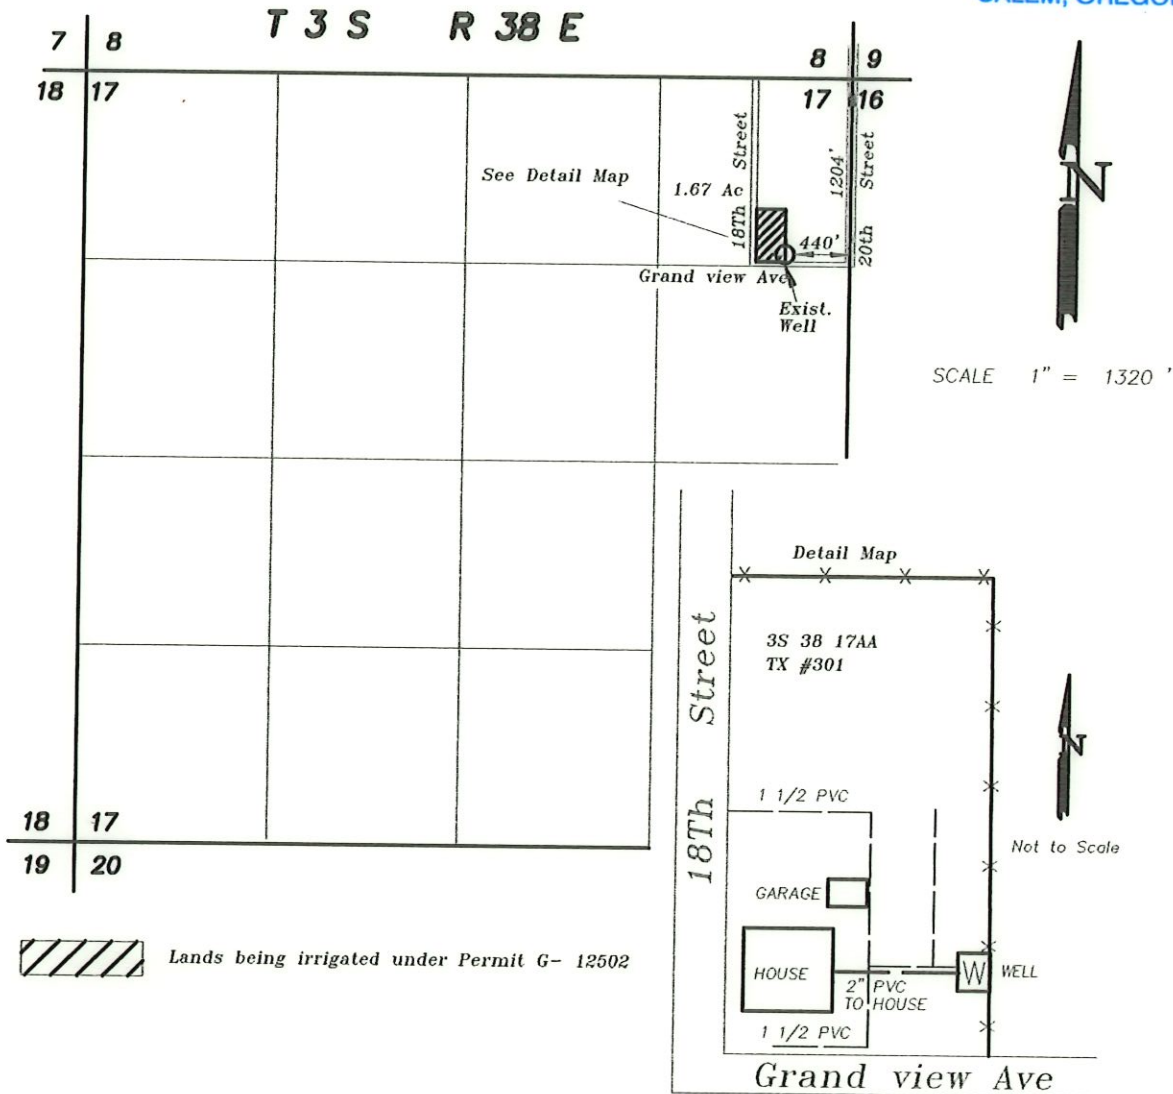

NOTE: The preparation of this map was for the purpose of identifying the location of the proposed water right and has no intent to provide dimensions or location of property ownership lines. Location information shown hereon was furnished by the applicant.

**FINAL PROOF MAP OF
WATER RIGHTS**

FOR
ELIZABETH VENN

BY
BAGETT - GRIFFITH & BLACKMAN
2006 ADAMS AVENUE
LAGRANDE, OREGON 97850

October 1, 1999

APPLICATION NO. G- 13718

PERMIT NUMBER G- 12502