


Township 13 South, Range 16 East.

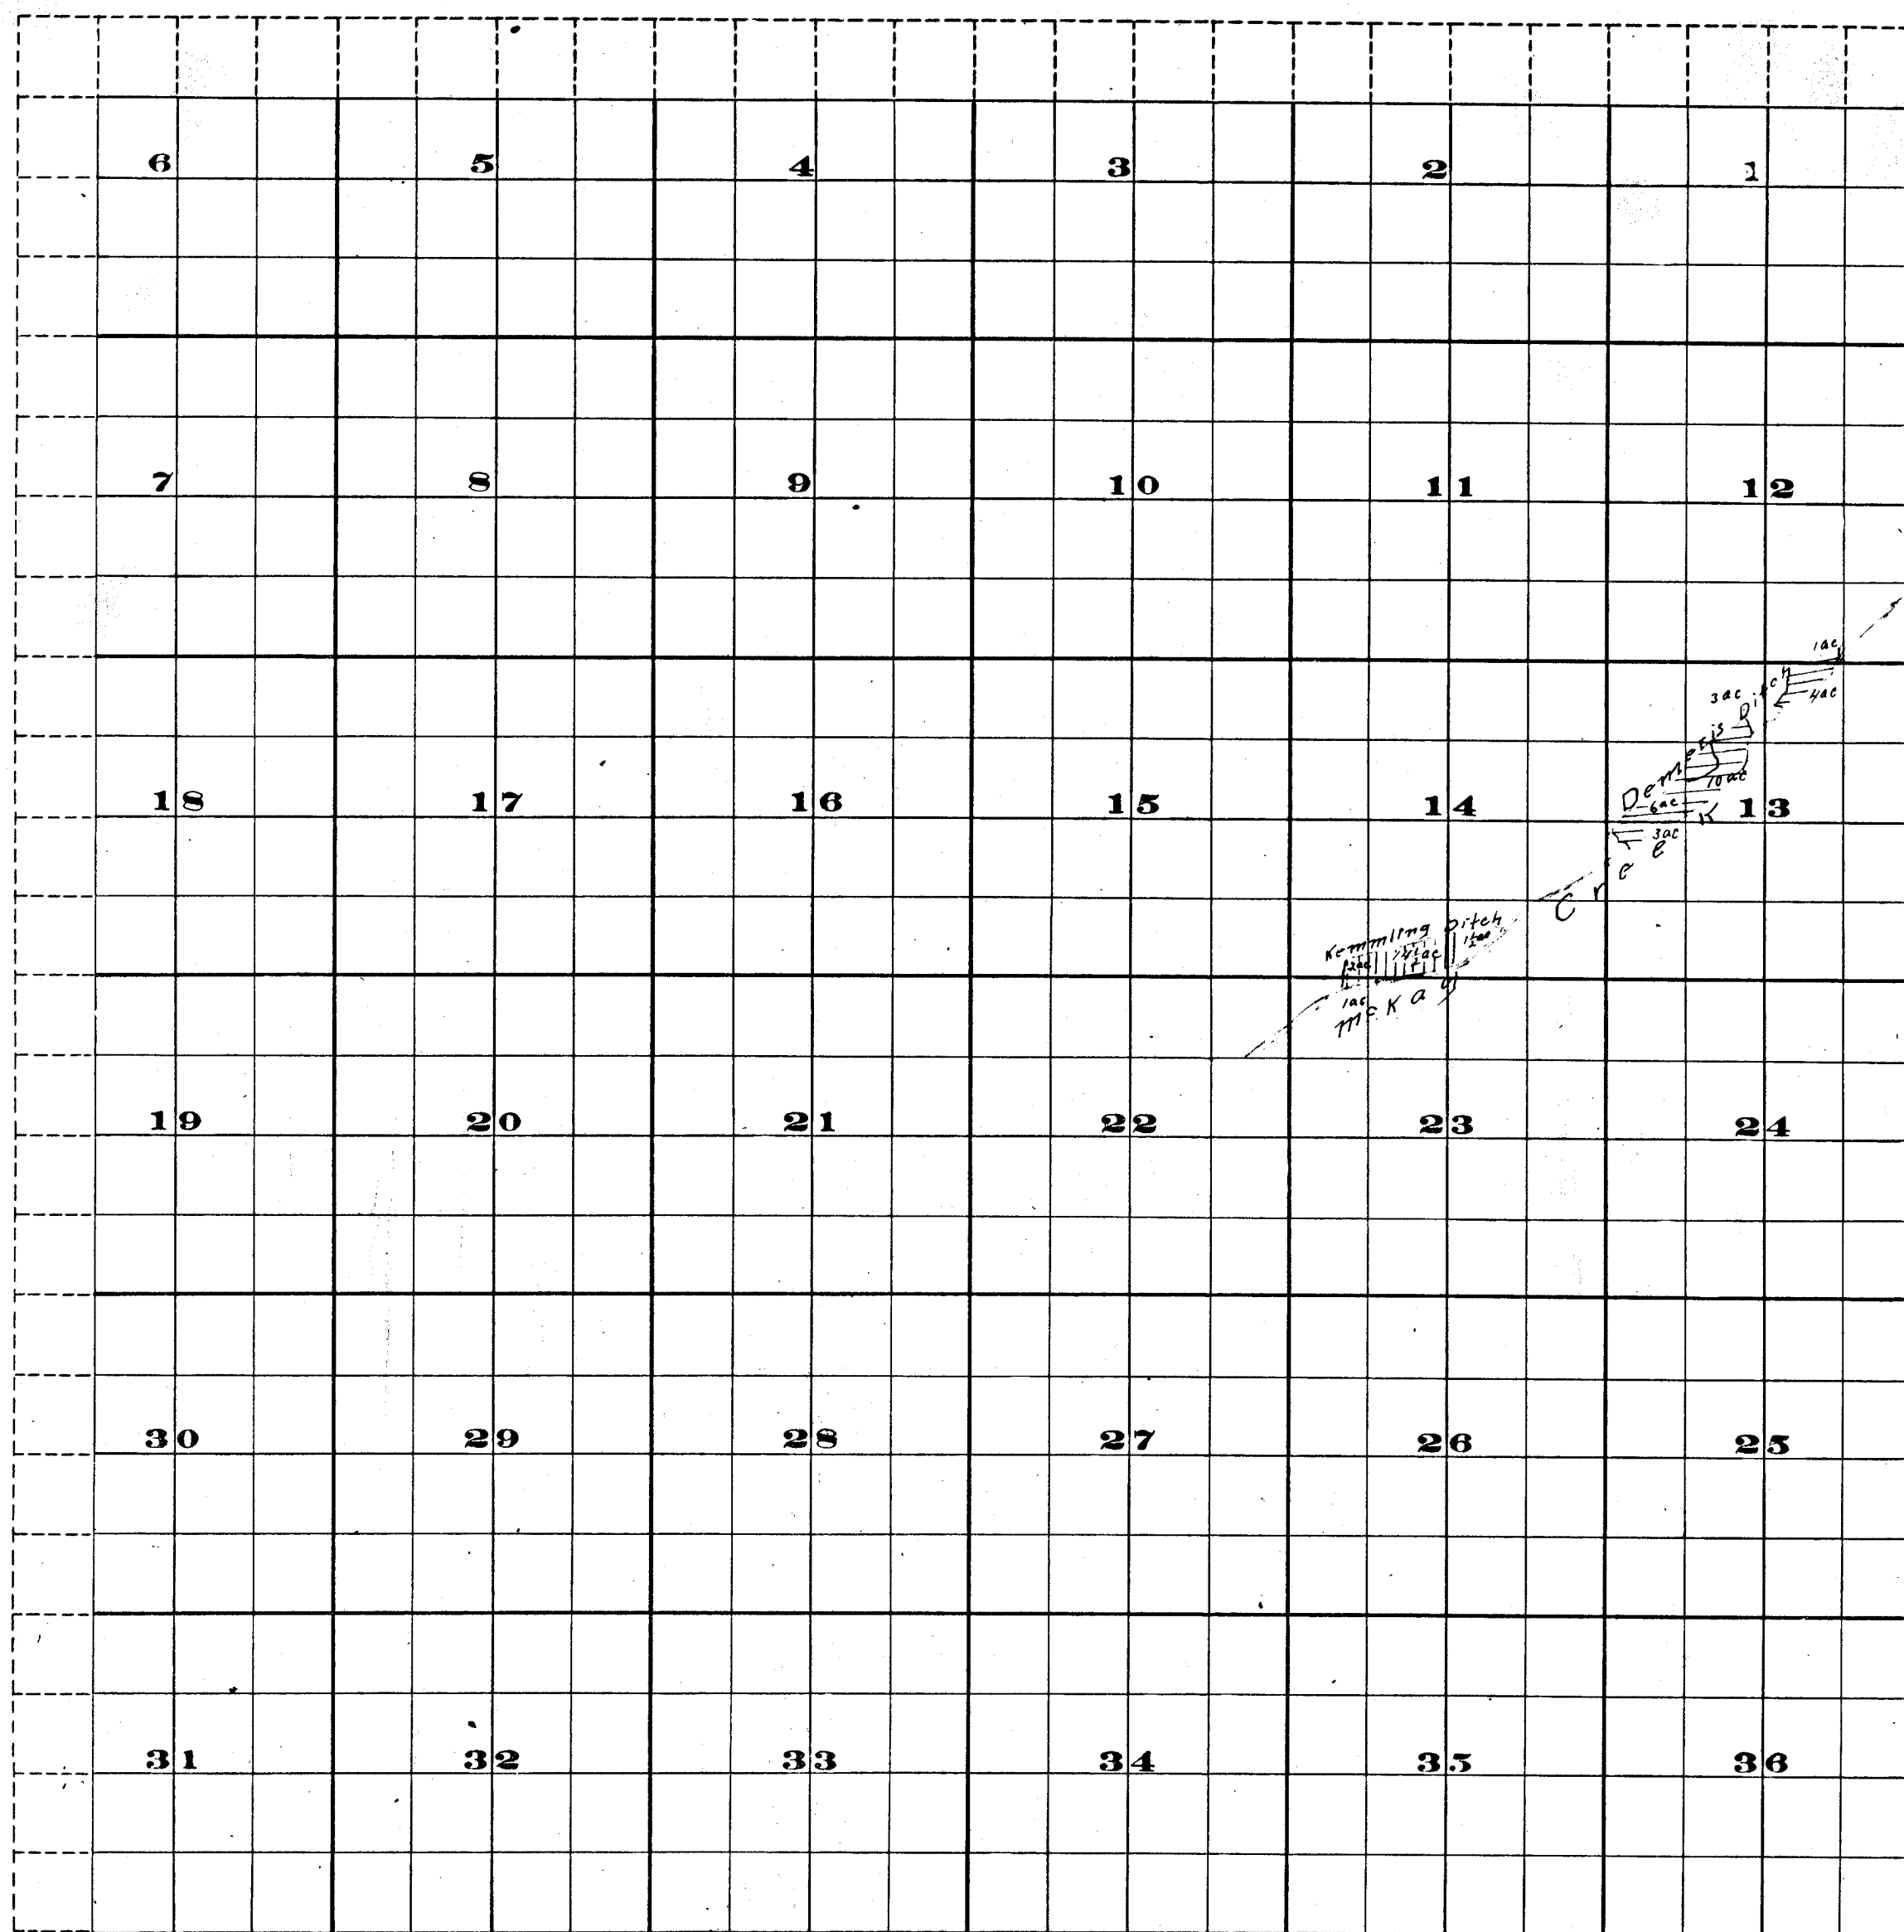

Survey by H.K. Donnelly Oct. 1909

FROM OFFICE OF THE STATE ENGINEER, SALEM, OREGON

John H. Lewis State Engr.

Crooked River Adjudication

Examined Oct. 17th 1910