


T. 8S., R. 39E., W.M.

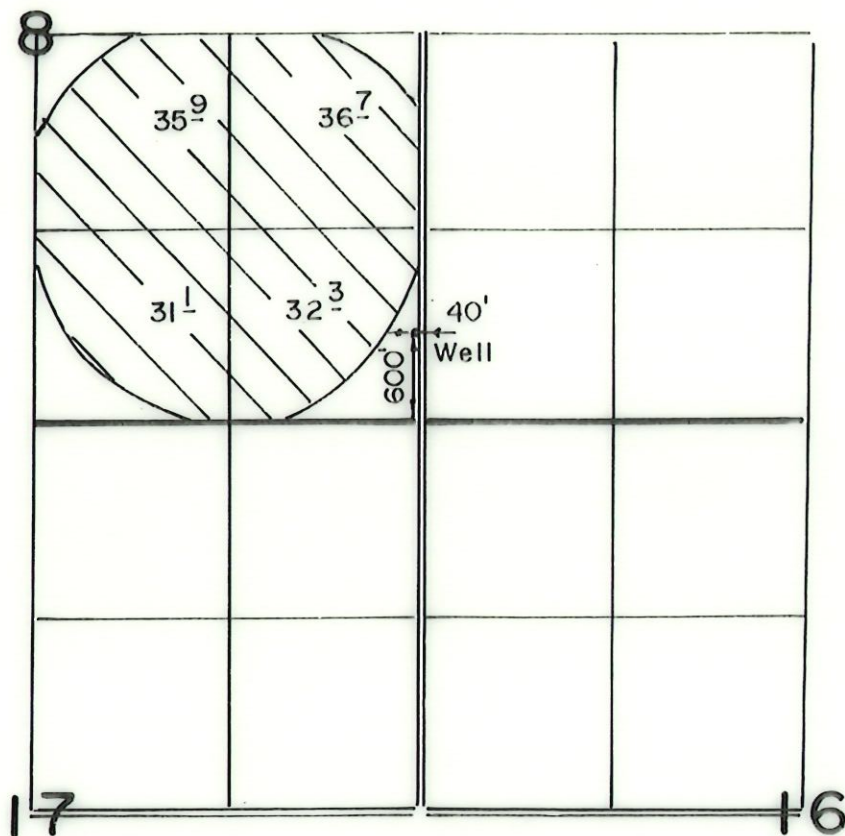

SCALE 1" = 1320'

The purpose of this map is for identifying the location of the water right only and is not intended to provide legal dimensions of property ownership lines.


FINAL PROOF SURVEY

APPL. G-13203 PER. G-12937

IN NAME OF

Blatchford Brothers

SURVEYED SEPT. 27, 2000

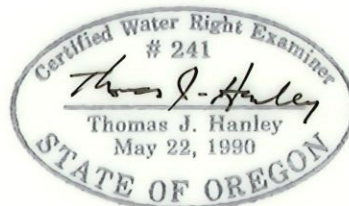

RECEIVED

OCT 02 2000

WATER RESOURCES DEPT.
SALEM, OREGON