

APR 08 2026

T.4S. R.1E Section 26, W.M.

Salem, OR

SWNE

SENE

Well (CLAC 77869) is located 190 feet south and 1,510 feet east from the center of Section 26. (45.193669, -122.644972), WGS 84 datum.

 Area (19.2 Acres) irrigated under Application G-18876, Permit G-18698.

----- Tax lot boundary

..... Water main line

TL 4 1E 26 800

18.6

0.6


Well
(CLAC 77869)
and meter

S. Heinz Rd.

S. Elisha Rd.

NWSE NESE

Scale: 1" = 400'

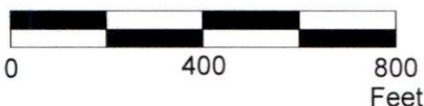

This map was prepared for the purpose of identifying the location of a water right only and is not intended to provide legal dimensions or location of property ownership lines.

Claim of Beneficial Use Map
Application G-18876, Permit G-18698

Marina Sharabarin
T.4S. R.1E. Section 26, W.M.

 WILL MCGILL SURVEYING LLC

03/2026
Rev: 04/2026

