CLAIM OF BENEFICIAL USE AND FINAL PROOF MAP

FOR

CARL & JULIE PERRY


T40S, R10E, Sec. 29 & 32 W.M. KLAMATH COUNTY, OREGON
APPLICATION NO. G-15617 PERMIT NO. G-15299

LEGEND

- SECTION LINES
- 1/4 1/4 LINES
- ROADS
- TAX LOT BOUNDARY
- KID DITCH
- 12" PVC PIPE UNDERGROUND
- 6" ALUM. PIPE ABOVE GROUND
- WHEEL LINE
- PIVOT
- HAND LINE
- EXISTING WELL & FLOW METER (POA-1)
- (2) PUMPS
- 39.2 NENW — IRRIGATED ACRES PER 1/4 1/4; 1/4 1/4 SECTION
- TL1000 — TAX LOT NUMBER
- IRRIGATED AREA
- 32 — SECTION CENTER
- 29 | 28 / 32 | 33 — SECTION CORNER

N

1320 660 0 1320
(FEET)

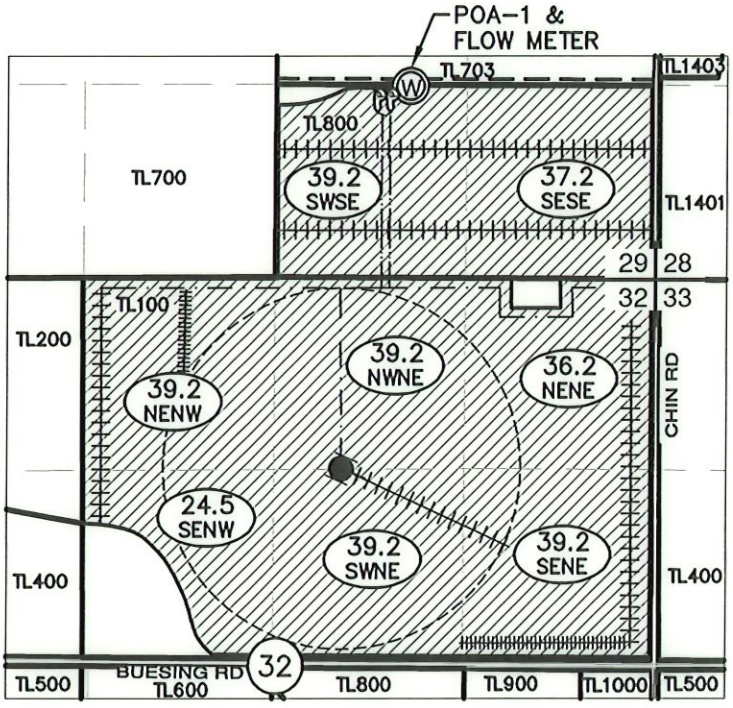

NOTES

1. THIS MAP WAS PREPARED FROM FIELD MEASUREMENTS, NAIP 2005 AERIAL PHOTOGRAPH, AND KLAMATH COUNTY TAX MAPS 40 10 29 & 40 10 32.
2. THE PURPOSE OF THIS MAP IS TO IDENTIFY THE LOCATION OF THE PROPOSED WATER RIGHT ONLY, AND IS NOT INTENDED TO PROVIDE LEGAL DIMENSIONS OR LOCATIONS OF PROPERTY OWNERSHIP.
3. FOR TAX LOT INFORMATION, SEE TAX MAPS 40 10 29 & 40 10 32.
4. THE DATE OF PRIORITY FOR THIS APPLICATION IS SEPTEMBER 17, 2001.

WELL TIE

WELL IS LOCATED IN THE SW¼ SE¼ OF SECTION 29, 1320 FEET NORTH AND 1700 FEET WEST FROM THE SE CORNER OF SECTION 29, T40S, R10E, W.M.

Carl Perry
APPLICANT SIGNATURE

Julie Perry
APPLICANT SIGNATURE

CERTIFIED WATER RIGHT EXAMINER
#88332CWRE
Daniel B. Scalas
April 23, 2015
STATE OF OREGON

RENEWAL 06/30/18

RECEIVED
JUN 28 2018
OWRD

ADKINS
CONSULTING ENGINEERING, LLP
Engineers ▲ Planners ▲ Surveyors
1435 Esplanade Ave · Klamath Falls, Oregon 97601 · (541) 884-4666 · FAX (541) 884-5335
Oregon · California

3/29/2018

3352-01