T-6556

T. 13 S., R. 16 E., W. M.

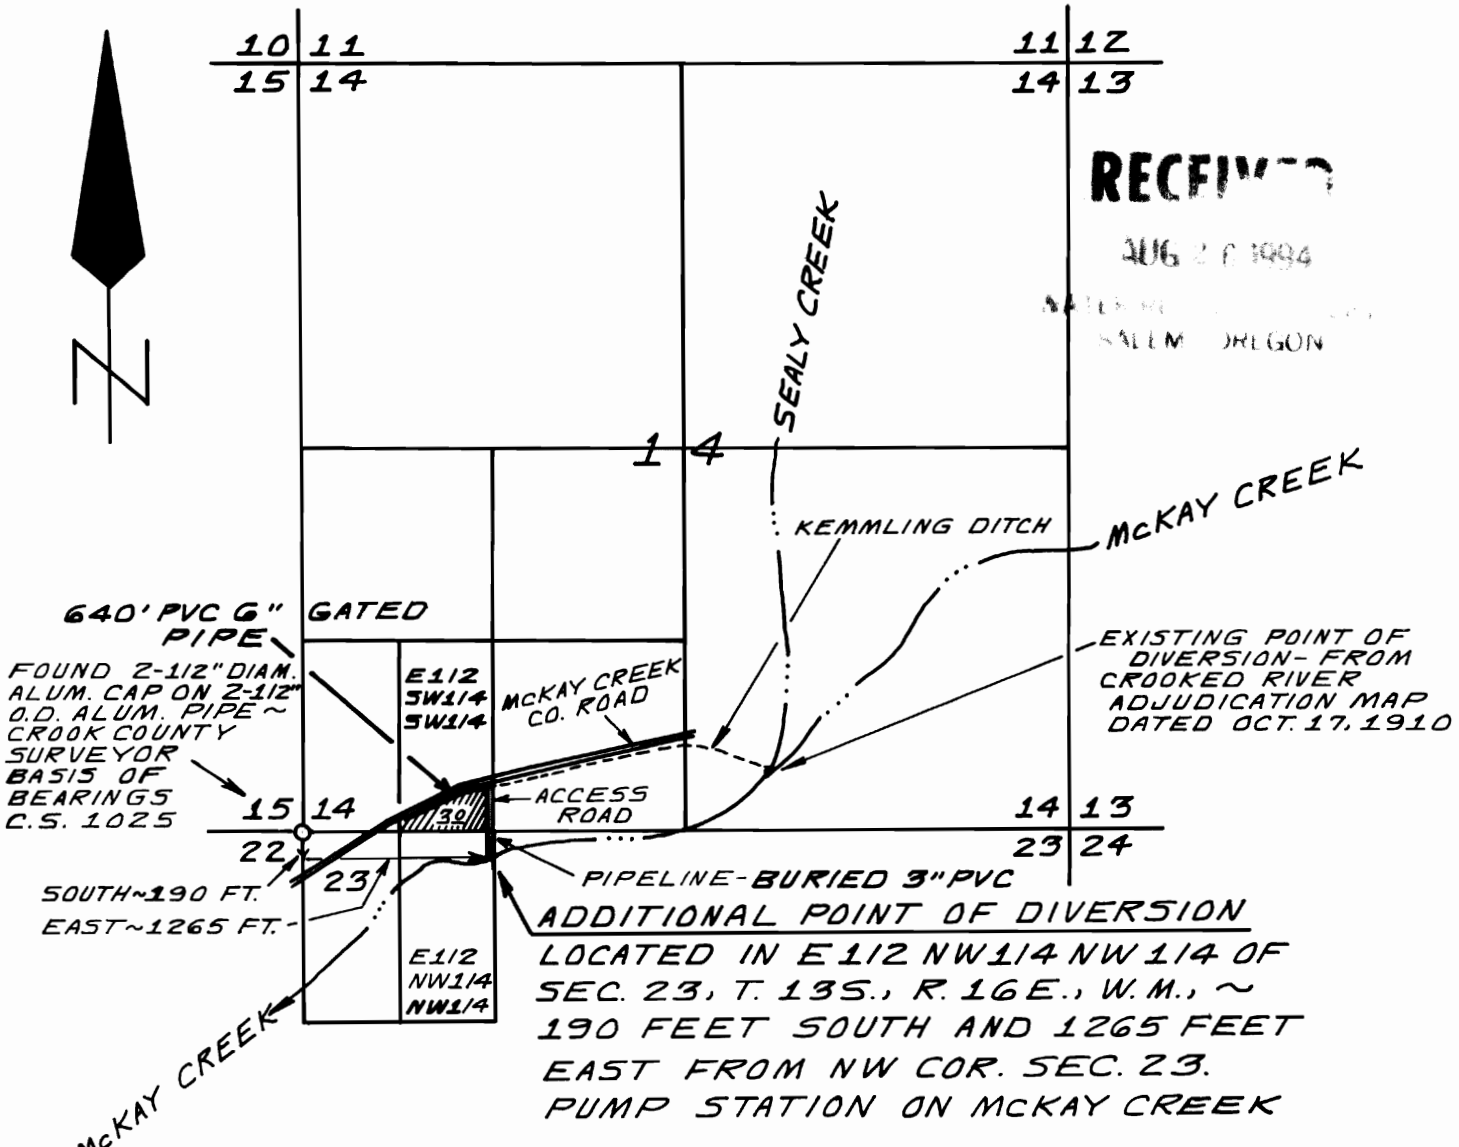

RECEIVED
AUG 2 6 1994
WATER RESOURCES DEPT.
SALEM, OREGON

ADDITIONAL POINT OF DIVERSION
LOCATED IN E1/2 NW1/4 NW1/4 OF SEC. 23, T. 13S., R. 16E., W.M., ~ 190 FEET SOUTH AND 1265 FEET EAST FROM NW COR. SEC. 23.
PUMP STATION ON McKAY CREEK

SURVEY NOTE

THE PREPARATION OF THIS MAP IS FOR THE PURPOSE OF IDENTIFYING THE LOCATION OF THE WATER RIGHT ONLY AND HAS NO INTENT TO PROVIDE DIMENSIONS OR LOCATIONS OF PROPERTY OWNERSHIP LINES.

LOCATION SOURCE

FIELD SURVEY 4-5-91
FIELD BOOK 87
FINAL PROOF INSPECTION ON AUG. 19, 1994

PREPARED FOR

HAROLD E. DAVIS
DOROTHY A. DAVIS
309842 McKAY CR. RD.
PRINEVILLE, OR 97754
[503] 447-1185

WATER RIGHT

CROOKED RIVER DECREE
CERT. NO. 592 RECORDED VOL. 1 ON PAGE 324.

ARMSTRONG SURVEYING & ENGINEERING, INC.
378 EAST SECOND STREET
PRINEVILLE, OREGON 97754
[503] 447-7791

Certified Water Right Examiner
145
David B. Armstrong
8/19/94
Renewal 12/31/95

SCALE: 1" = 1320' | DATE: AUG. 19, 1994 | W.O. 91-813