AMENDED

CLAIM OF BENEFICIAL MAP FOR TRANSFER T-10459 to CHANGE THE PLACE OF USE AND POINT OF DIVERSION UNDER CERT 60455/PERMIT S-46499 IN THE NAME OF SCOTT MADISON UMATILLA COUNTY, T3N R28E W.M.

E-RECEIVED
SEPT 28 2026
OWRD

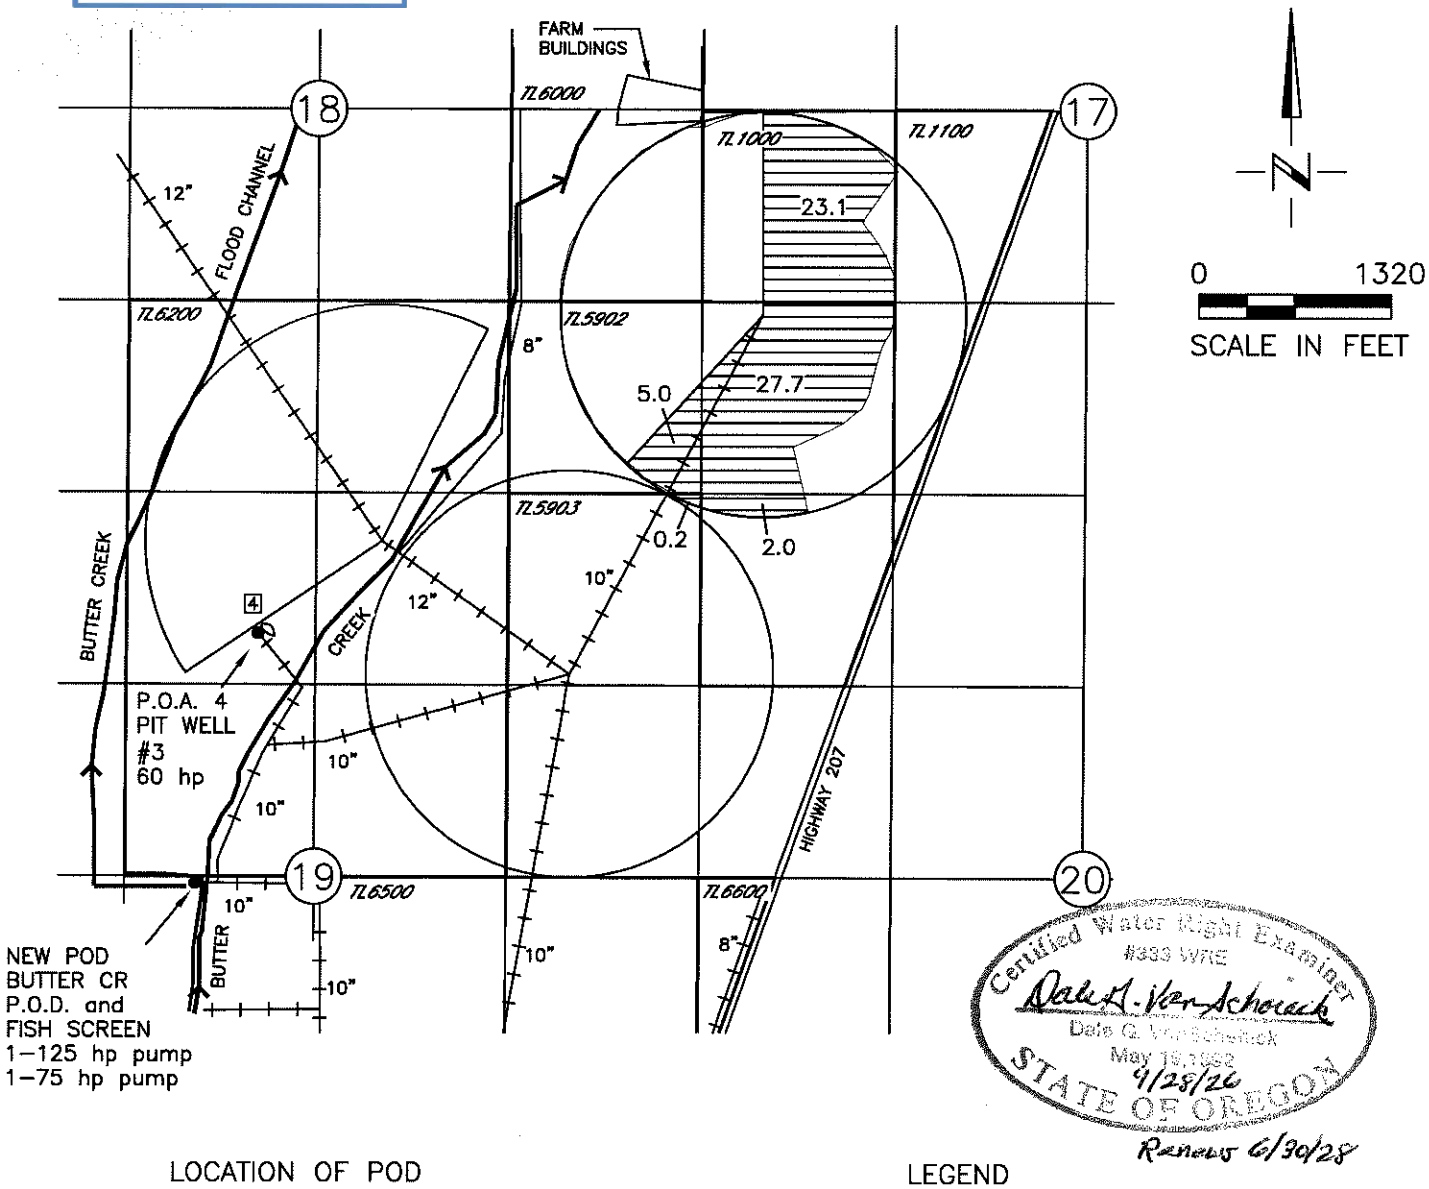

Renews 6/30/28

LOCATION OF POD

- ORIGINATING CERT 60455/PERMIT S-46499 NEW P.O.D., BUTTER CR POD LOCATED IN THE NESW OF SEC 19, 10'S AND 1800'E FROM THE WEST 1/4 CORNER OF SECTION 19

LEGEND

- ORIGINATING CERT 60455/PERMIT S-46499 PRIMARY IRR 58.0 AC
- BURIED PIPELINE
- TAX LOT BOUNDARY

NOTE:
THE PURPOSE OF THIS MAP IS TO IDENTIFY THE APPROXIMATE LOCATION OF THE WATER RIGHT. IT IS NOT INTENDED TO PROVIDE INFORMATION RELATIVE TO THE LOCATION OF PROPERTY OWNERSHIP BOUNDARY LINES.

DGV Consulting, PLLC
PHONE (509) 627-8717
dalevconsulting@gmail.com

Date: Sept 28, 2026